


Section 3 Township 14 Range 16WWell No. #1 DreilingCompany Lindas Oil

NORTH

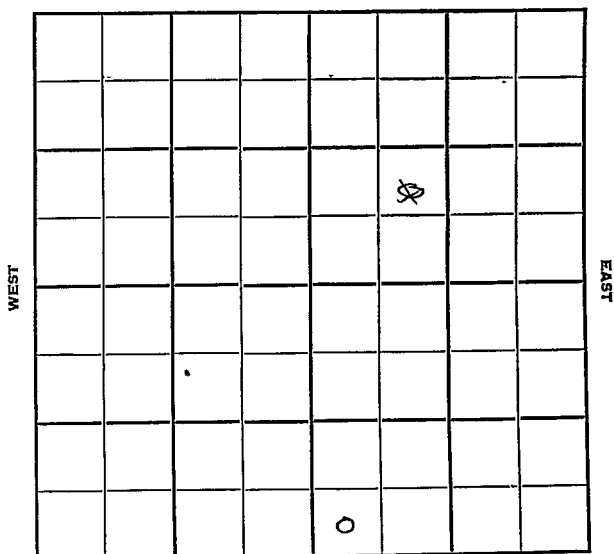

Ellis

KANSAS

Sec. 3 Twp. 14 R. 16 W

Well No. # 1 Dreiling Farm

Lindas Oil Company


Wildcat Contractor

 Ft. from N. Line

330 Ft. from S. Line

 Ft. from E. Line

330 Ft. from W. Line

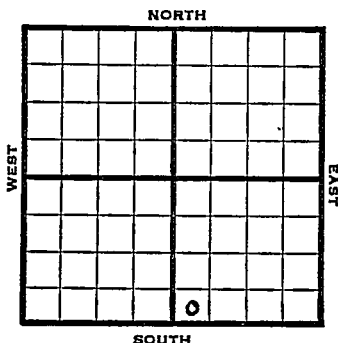

SW SW SE
Lion - DHM

1952 Elev. 1940' REPORT

1/30 Location

2/6 Drlg. 2125'

2/13 Heeb. 3140 Lans. 3178
DST 3185-3240 1 hr. 20' mud
Arb. 3439
DST 3420-44 TD 1 hr 40' mud &
free oil 5" @ 3440
Drlg. 3442'

2/20 MIST

2/27 Spud 1-31-52
D&A TD 3445
8" @ 208

Anhy 1033 Heeb. 3140

Lans. 3178

DST 3185-3240 open 1hr. rec. 20' mud

Arb. 3439


DST 3420-44 open 1 hr. rec. 40' ocm &
free oil 5" @ 3440 DD 3445

2o/ 3441-45 SSO 500 A

FU 1900' sw & SSO 3 hr.

D&A

ABANDONED

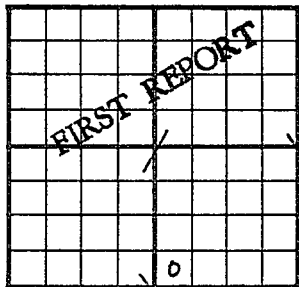County Ellis State KansasSec. 3 (^{Blk.}_{Twp.}) 14 (^{Sur.}_{Rge.}) 16W Map No.Operator Lindas Oil.Well No. 1 Farm DreilingElev. 1940 Location SW SW SE330 Ft. From S Line SE330 Ft. From W Line Quarter1st. Report JAN 30 1952

Completion

Remarks Lion - DHM

Spudding Date

Drlg. Data


WildcatLocationJ. G. McGEHEE

County Ellis State Kansas
 Sec. 3 (Blk.) 14 (Sur.) 16W Map No.

Operator Lindas Oil

Well No. 1 Farm Dreiling

Elev. 1940 Location SW SW SE

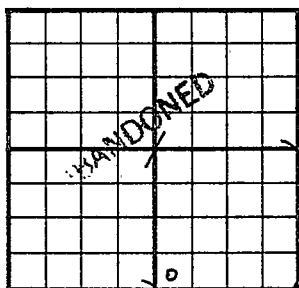

330 Ft. From S Line SE

330 Ft. From W Line Quarter

1st. Report

Completion FEB 27 1952

Remarks Wildcat

Spudding Date 1-31-52

Drilg. Data D & A TD 3445

8" @ 208 Anhy 1033 Heeb. 3140

Lans. 3178 DST 3185-3240 open 1 hr.

Rec. 20' mud Arb. 3439 DST 3420-44

open 1 hr. Rec. 40' ocm & free oil

5" @ 3440 DD 3445 20/ 3441-45

SSO 500 A FU 1900' sw & SSO 3 hr.

D & A

J. G. McGEHEE