




Russell

Map No. KANSAS Sec. 3 Twp. 14 R. 15<sup>w</sup>

Well No. 7- Witt Farm

Bridgeport Machine Company

990 Ft. from N. Line  
 \_\_\_\_\_ Ft. from S. Line  
 \_\_\_\_\_ Ft. from E. Line  
990 Ft. from W. Line

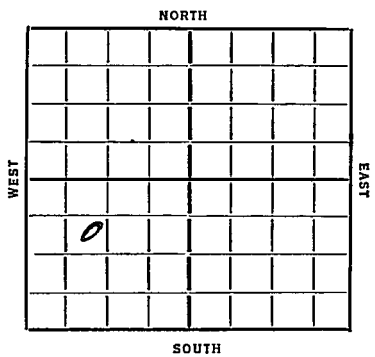

Date	REPORT
12/3	
12/4	Rgn Cable Tools
12/19	12" 607 10" 918
12/26	Dly 1580
12/36	" 2415
1/10	8" 2515 to 2955-60
	Top Rev. 3035 6" 3035
	Pay 3058-60 800' OTH 1hr
	Pay 3073-80 3104-12
	Skipped 65-75 lbs Oil per
	hr 2000 acid
1/15	Oswald 3035
	TD 3112
	2000 acid
	1168 Blk.

COMPLETED

*Russell*  
 Map No. 72 Sec. 3 Twp. 14 R. 15N  
 Well No. 7-Witt  
Bridgport Machine Company  
 Contractor

FIRST REPORTS SECTION PLAT

990 Ft. from N. Line  
 ..... Ft. from S. Line  
 ..... Ft. from E. Line  
990 Ft. from W. Line

	0		

Location.....  
 Rig up.....  
 Drilling and Remarks:

*Rigging  
 cable tools*

RECORD

Cased.....in., .....ft.  
 Sand.....  
 Gas.....  
 Oil.....  
 Total Depth.....

PRODUCTION

1st 24 hrs. Nat.....  
 1st 24 hrs. after shot.....  
 Gas.....Cu. Ft.  
 Dry Hole.....  
 Abandoned.....

Date

12-4-35 192.....

**ORVAL MANN-CHECK**

Scout

Sam - Our tracing shows only one  
well on this lease. Advise.

Pittman,  
Eng. Dept.

Advise

Thanks  
SAM

Sam:  
#7 - well is correct  
and there is only 1 well  
on lease.

H.D.H.

R 1 red	<input checked="" type="checkbox"/>
Cards	<input checked="" type="checkbox"/>
Tracing	<input checked="" type="checkbox"/>
Francis Map	<input checked="" type="checkbox"/>
Scarborough Map	<input checked="" type="checkbox"/>
Moody Map	<input checked="" type="checkbox"/>
Scarborough Plat Book	<input type="checkbox"/>
Moody Plat Book	<input type="checkbox"/>

KANSAS

Map No. 72 Sec. 3 Twp. 14 R. 15<sup>n</sup>

Well No. 7-Witt

Bridgport Machine Company  
Contractor

**COMPLETE**

**SECTION PLAT**

990 Ft. from N. Line

..... Ft. from S. Line

..... Ft. from E. Line

990 Ft. from W. Line

	⊙		

Location.....

Rig up.....

Drilling and Remarks:

2000 sand  
1168 bbls

**RECORD**

Cased..... in. .... ft.

~~sand~~ Orval 3035

Gas.....

Oil.....

Total Depth 3112

**PRODUCTION**

1st 24 hrs. Nat.....

1st 24 hrs. after shot.....

Gas..... Cu. Ft.

Dry Hole.....

Abandoned.....

Date

**ORVAL MANNSCHRECK**

1-15-36 192..... Scout

*Handwritten scribbles and lines, possibly initials or a signature.*

1	<i>CPM</i>
2	<i>Jan</i>
3	<i>X</i>
4	<i>X</i>
Scanned by *X* Book  
Mocdy Plot Book