
KANSAS Russell

Form 51—5M—4-36—Palace

Section 3 Township 14 Range 15-W

Well Number 8-Witt

Company Witt

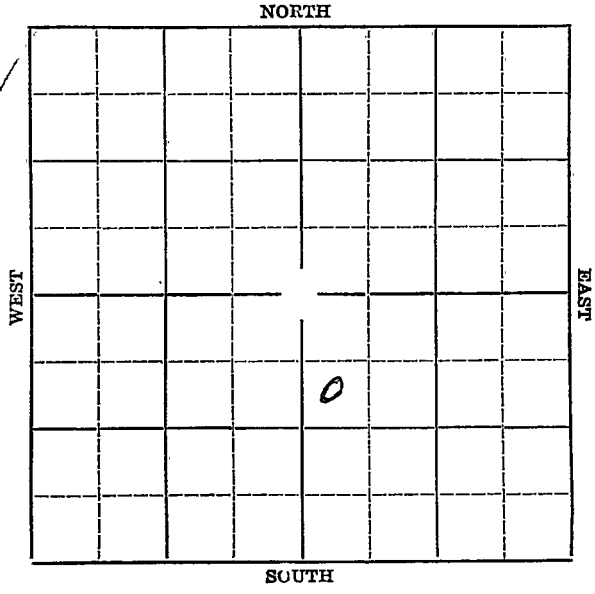

Form 252-A
5M 7-35 MPC

KANSAS Russell

Map No. ' Sec. 3 Twp. 14 R. 15W

Well No. #8 Witt Farm


Witt Company

990' Ft. from N. Line

Ft. from S. Line

Ft. from E. Line

330' Ft. from W. Line

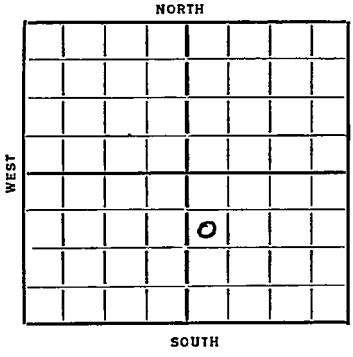

Elev. 1884

Date 1936	REPORT
4/29	Location
5/7	Building rig.
5/14	--
5/21	383' of 15".
5/28	Drlg. 1445'.
6/4	Drlg. 2510'.
6/11	Drlg. 2805'. 8" @ 2775'.
6/24/36	Oswald 3048'.
	4000 gallons acid.
	T.D. 3135'.
	Potential 344 bbls of oil.
	COMPLETED

Form 26—1M Blks. 9-28

Phillips

KANSAS

Map No. 72 Sec. 3 Twp. 14 R. 15-W

Well No. 8 Veith

Veith Company

Contractor


SECTION PLAT

990 Ft. from N. Line

Ft. from S. Line

Ft. from E. Line

990 Ft. from W. Line

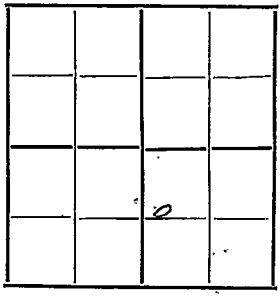

FIRST REPORT

Location ✓

Rig up

Drilling and Remarks:

RECORD

Cased in., ft.

Sand

Gas

Oil

Total Depth

PRODUCTION

1st 24 hrs. Nat.

1st 24 hrs. after shot

Gas Cu. Ft.

Dry Hole

Abandoned

Date

APR 29 1936 192

[illegible] LEWIS Scout

Form 26—1M Blk—2-29

KANSAS


Map No. 72 Sec. 3 Twp. 14 R. 15W

Well No. 8 Hitt

Hitt Company

Contractor

SECTION PLAT

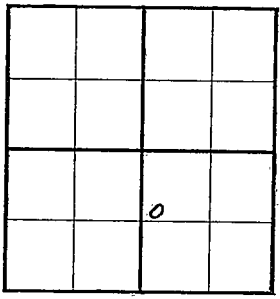

990 Ft. from N. Line

Ft. from S. Line

Ft. from E. Line

330 Ft. from W. Line

COMPLETED

Location

Rig up

Drilling and Remarks:

Oswald 3048

400 acid

Potential 344

RECORD

Cased in., ft.

Sand

Gas

Oil

Total Depth 3135

PRODUCTION

1st 24 hrs. Nat.

1st 24 hrs. after shot

Gas Cu. Ft.

Dry Hole

Abandoned

Date

JN 24 1936

19 S. J. LEWIS Scout