


Section 3 Township 14 Range 15WWell Number #23 ~~#29~~ ~~#3~~ WittCompany Billings

NORTH

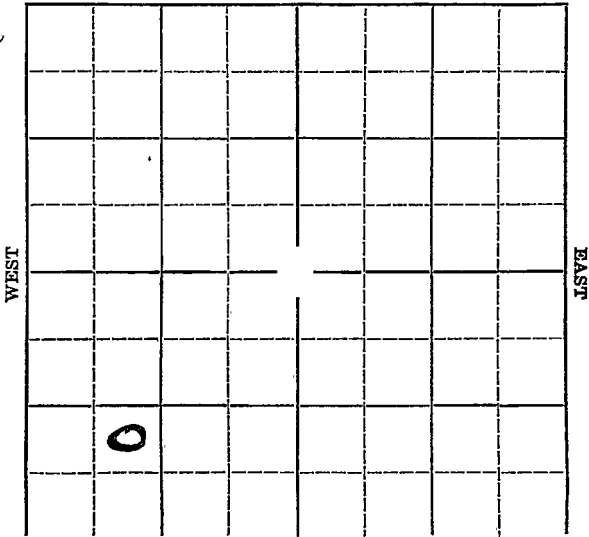

SOUTH


Map No. KANSAS Sec. 3 Twp. 14 R. 15W
Well No. #23 #8 Witt Farm
Billings Company

Ft. from N. Line

990' Ft. from S. Line

Ft. from E. Line

990' Ft. from W. Line

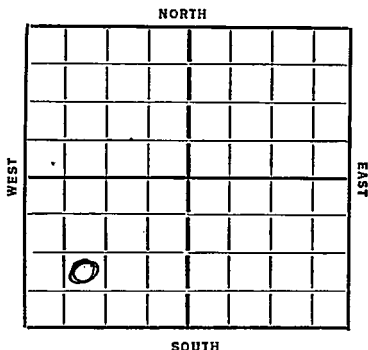

Date
1936

REPORT

5/27 Rigging up.

6/4-- 6/11-- 6/18-- 6/25--

7/2 Run 10" @ 906'.

7/9 Drlg. 2210'.

7/16 Drlg. 2905'. 8" @ 2483'.

7/22/36-Granite Wash 3289'.

T.D. 3313'.

Hole full of water.

D & a

COMPLETED

Map No. 72 Sec. 3 Twp. 14 R. 15 WWell No. 32477Bullings Company

Contractor

SECTION PLAT

0			

_____ Ft. from N. Line

990 Ft. from S. Line

_____ Ft. from E. Line

990 Ft. from W. Line

F. & A. REPORT

Location _____

Rig up _____

Drilling and Remarks:

Rigging up

RECORD

Cased _____ in., _____ ft.

Sand _____

Gas _____

Oil _____

Total Depth _____

PRODUCTION

1st 24 hrs. Nat. _____

1st 24 hrs. after shot _____

Gas _____ Cu. Ft.

Dry Hole _____

Abandoned _____

Date

MAY 27 1936 19

S. J. LEWIS

Scout

Map No. 72 Sec. 3 Twp. 14 R. 15WWell No. 29 WettBillings Company

Contractor

SECTION PLAT

_____ Ft. from N. Line

990 Ft. from S. Line

_____ Ft. from E. Line

990 Ft. from W. Line

CORRECTION

Location _____

Rig up _____

Drilling and Remarks:

Reported
at No 3

RECORD

Cased _____ in., _____ ft.

Sand _____

Gas _____

Oil _____

Total Depth _____

PRODUCTION

1st 24 hrs. Nat. _____

1st 24 hrs. after shot _____

Gas _____ Cu. Ft.

Dry Hole _____

Abandoned _____

Date

JUN 24 1936

19

G. I. EWING

Scout

Map No. 72 Sec. 9 Twp. 14 R. 15WWell No. 23 SkiffBillings Company

Contractor

SECTION PLAT

0			

 Ft. from N. Line990 Ft. from S. Line Ft. from E. Line990 Ft. from W. Line

CORRECTION

Location Rig up

Drilling and Remarks:

Case No 29

RECORD

Cased in., ft.Sand Gas Oil Total Depth

PRODUCTION

1st 24 hrs. Nat. 1st 24 hrs. after shot Gas Cu. Ft.Dry Hole Abandoned

Date

JUL 22 1930 19S. J. LEWIS Scout

KANSASMap No. 72 Sec. 3 Twp. 14 R. 15WWell No. 23 WittBillings Company

Contractor

SECTION PLAT

0			

_____ Ft. from N. Line

990 Ft. from S. Line

_____ Ft. from E. Line

990 Ft. from W. Line**ABANDONED**

Location _____

Rig up _____

Drilling and Remarks:

Granite Hark
3289J & H**RECORD**

Cased _____ in., _____ ft.

Sand _____

Gas _____

Oil _____

Total Depth 3313**PRODUCTION :**

1st 24 hrs. Nat. _____

1st 24 hrs. after shot _____

Gas _____ Cu. Ft.

Dry Hole _____

Abandoned _____

Date

JUL 22 193619S. J. LEWIS Scout.