


Russell
14 R. 15W

Map No. KANSAS Sec. 3 Twp. 14 R. 15W

Well No. 8- Witt Farm
Bridgeport Machine Company

NORTH

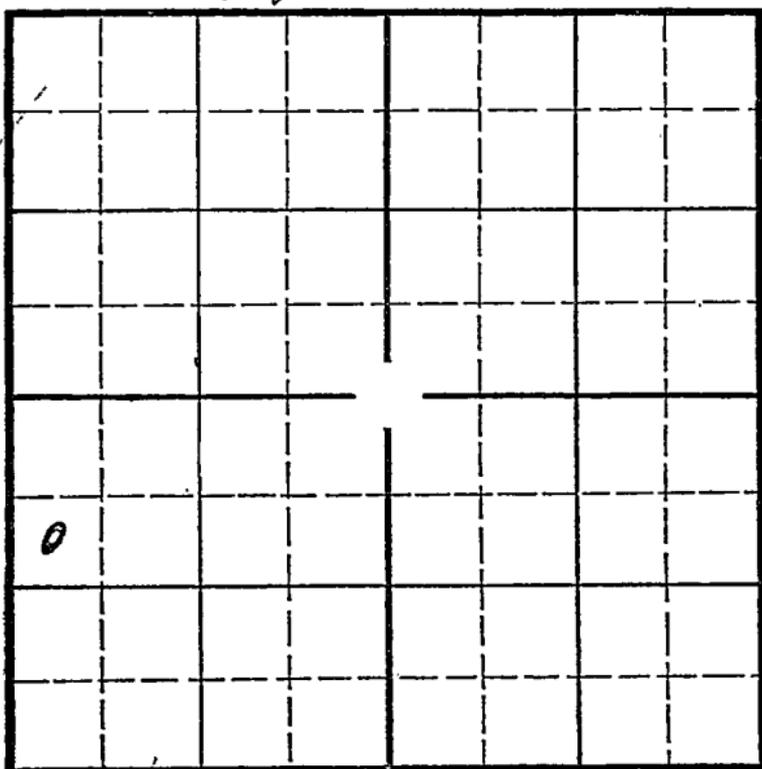

Location _____

Drilling Remarks _____

Rig Up _____

Drilling Remarks _____

RECORD

Cased _____ in. _____ ft.

Sand _____

Gas _____

Oil _____

Total Depth _____

PRODUCTION

1st 24 hrs. Nat. _____

1st 24 hrs. after shot _____

Gas _____ cu. ft. _____

Dry Hole _____

Abandoned _____

Russell

Map No. KANSAS Sec. 3 Twp. 14 R. 15^w

Well No. 8 - Witt Farm

Bridgeport Machine Company


990 Ft. from N. Line

_____ Ft. from S. Line

_____ Ft. from E. Line

330 Ft. from W. Line

Elev. 1874

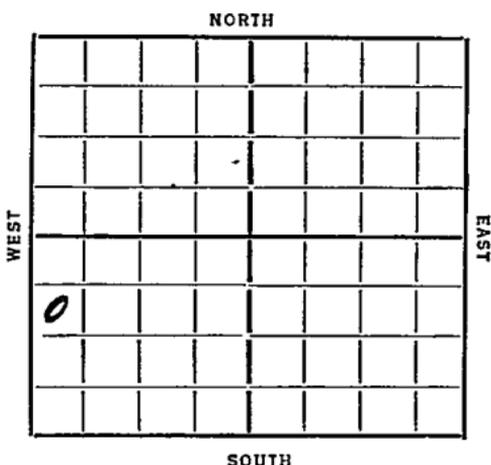

REPORT

~~1936~~
1/15 Cellar & Skidding Rig

1/24 D.R.

1/31 15" 408 12" 613 10" 913

Dlg 1005

2/7 " 2050

2/14 TD 2505 Hung 8"

2/21 8" 2505 Lams 3034

6" 3040 Dlg 3055

2/28 TD 3100 1000 acid

3/6 776 Bbls Oil 18 hrs

With retet

3/11 Lamsing 3034

TD 3110

1000 acid

800 Bbls.

COMPLETED

Map No. 72 Sec. 3 Twp. 14 R. 15W

Well No. S-Witt

Bridgeport Machine Company

Contractor

FIRST REPORTS

SECTION PLAT

990 Ft. from N. Line

..... Ft. from S. Line

..... Ft. from E. Line

330 Ft. from W. Line

Location.....

Rig up.....

Drilling and Remarks:

Cellar + Skidding Rig

RECORD

Cased.....in.,ft.

Sand.....

Gas.....

Oil.....

Total Depth.....

PRODUCTION

1st 24 hrs. Nat.....

1st 24 hrs. after shot.....

Gas.....Cu. Ft.

Dry Hole.....

Abandoned.....

Date

1-15-36 192.....

ORVAL MANNSCHECK

Scout

Map No. 72 Sec. 3 Twp. 14 R. 15WWell No. 8-WittBridgeport Machine Company

Contractor

COMPLETE990 Ft. from N. Line

..... Ft. from S. Line

..... Ft. from E. Line

330 Ft. from W. Line

SECTION PLAT

Location.....

Rig up.....

Drilling and Remarks:

1000 acid800 bbls

RECORD

Cased..... in., ft.

Sand 3034

Gas.....

Oil.....

Total Depth 3110

PRODUCTION

1st 24 hrs. Nat.....

1st 24 hrs. after shot.....

Gas..... Cu. Ft.

Dry Hole.....

Abandoned.....

Date

3-11-36 192.....

ORVAL MANNSCHRECK

Scout