

KANSAS

Form 51-5M-7-39-Palace


Russell

Section 3 Township 14 Range 15-W

Well No. #7 Witt


Company A. H. Witt

NORTH Gorham Pool

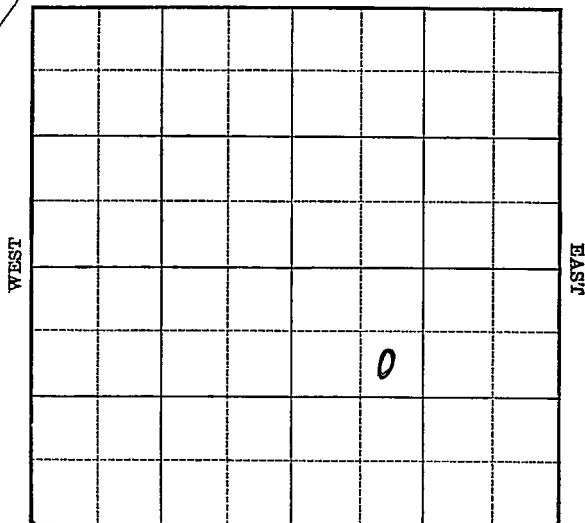

						0			

SOUTH

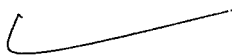

KANSAS

Russell

Sec. 3 Twp. 14 R. 15-WWell No. #7 Witt FarmA. H. Witt

Company

(Gorham)

990

Ft. from N. Line


Ft. from S. Line

Ft. from E. Line

990

Ft. from W. Line

Elev. 1883

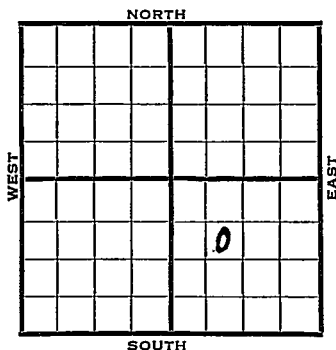

1940

REPORT

5/22

Cable.

5/29

Spud.

6/6

SD 1360'

6/13

20" - 20' 15" - 360'

12" - 615' Anhy 920'

10" - 925' Drlg. 2040'

6/20

8" - 2590' Fsg. 2675'

6/27

Topeka 2765' Lans. 3046'

7" - 3055' Drlg. 3115'

7/3

7" - 3159' S.O. 3255-60'

Drlg. 3293'

7/11

SD 3293'

7/18

Gorham 3294' T.D. 3297'

7" - 3294' Pump 3 bbls. per hour

7/24

Gorham 3294'

7" - 3294'

T.D. 3297'

Potential 132 bbls., pump.

COMPLETED

Map No. 72 Sec. 3 Twp. 14 R. 15WWell No. 7 WittA. H. Witt Company

Contractor

FIRST REPORT

SE NW SE

990 Ft. from N. Line Ft. from S. Line Ft. from E. Line990 Ft. from W. Line

GORHAM POOL

SECTION PLAT

Location Rig up

Drilling and Remarks:

Cable

RECORD

Cased in., ft.Sand Gas Oil Total Depth

PRODUCTION

1st 24 hrs. Nat. 1st 24 hrs. after shot Gas Cu. Ft.Dry Hole Abandoned

Date

MAY 22 1940

19

S. J. LEWIS

Scout

Map No. _____ Sec. 3 Twp. 14 R. 15WWell No. 7 WittA. H. Witt

Company

Contractor

COMPLETED**SECTION PLAT**

SE NW SE

990

Ft. from N. Line

Ft. from S. Line

Ft. from E. Line

990

Ft. from W. Line

GORHAM POOL

Location _____

Rig up _____

Drilling and Remarks:

*Gorham 3294**7" 3294**Pump 132 28***RECORD**

Cased _____ in., _____ ft.

Sand _____

Gas _____

Oil _____

Total Depth 3297**PRODUCTION**

1st 24 hrs. Nat. _____

1st 24 hrs. after shot _____

Gas _____ Cu. Ft.

Dry Hole _____

Abandoned _____

Date

JUL 24 1940 19S. J. LEWIS Scout