
KANSAS
Form 51—5M—4-36—Palace

Russell

Section 3 Township 14 Range 15-W

Well Number #2-Foster "A"

Company Central Pet.

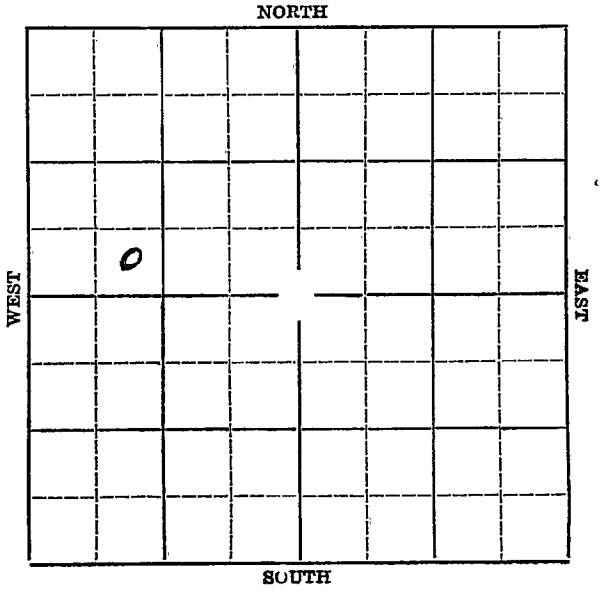


Form 252-A
5M 7-35 MPC

Russell

Map No. KANSAS Sec. 3 Twp. 14 R. 15W

Well No. #2 Foster "A" Farm

Central Pet. Company

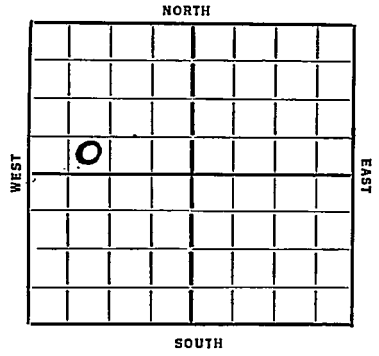

_____ Ft. from N. Line

330' Ft. from S. Line

_____ Ft. from E. Line

990' Ft. from W. Line

Elev. 1879

Date 1936	REPORT
7/1	Cellar.
7/9	Rigging up.
7/16	--
7/23	15" @ 375'. Drlg. 595'.
7/30	Drlg. 730'.
8/6	Drlg. 2220'. 8" @ 2207'.
8/13	8" @ 2530'. Drlg. 2635'.
8/20	8" @ 2715'. Show oil 2780'. Drlg. 2790'.
8/26	36-Oswald 3051'.
	T.D. 3064'.
	Pay 3051-57'.
	2000 gallons of acid.
	382 bbls of oil potential.
	COMPLETED

Form 26—IM Bks—2-29

KANSAS


Map No. 72 Sec. 3 Twp. 14 R. 15W

Well No. 2 Foster "A"

Central Pet. Company

Contractor

SECTION PLAT

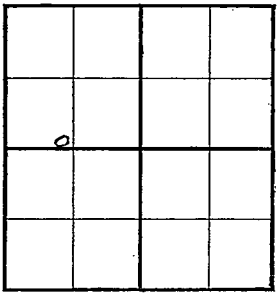

____ Ft. from N. Line

330 Ft. from S. Line

____ Ft. from E. Line

990 Ft. from W. Line

FIRST REPORT

Location ____

Rig up ____

Drilling and Remarks:

Cellar

RECORD

Cased ____ in., ____ ft.

Sand ____

Gas ____

Oil ____

Total Depth ____

PRODUCTION

1st 24 hrs. Nat. ____

1st 24 hrs. after shot ____

Gas ____ Cu. Ft.

Dry Hole ____

Abandoned ____

Date

JUL 1 1936 19

S. J. LEWIS Scout

Form 26—1M Bks—2-29

Russell

KANSAS


Map No. 72 Sec. 3 Twp. 14 R. 1

Well No. 2 Foster "A"

Central Pet. Compl

Contract

SECTION PLAT

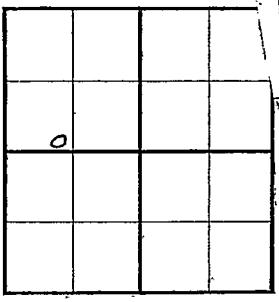

____ Ft. from N. Line

330 Ft. from S. Line

____ Ft. from E. Line

990 Ft. from W. Line

COMPLETED

Location ____

Rig up ____

Drilling and Remarks:

Oswald 3057

Pay 3051-57

2000 acid

Pd 382.

RECORD

Cased ____ in., ____ ft.

Sand ____

Gas ____

Oil ____

Total Depth 3064

PRODUCTION

1st 24 hrs. Nat. ____

1st 24 hrs. after shot ____

Gas ____ Cu. Ft.

Dry Hole ____

Abandoned ____

Date

AUG 26 1936 19__

S. J. LEWIS Scout