


Section 3 Township 14 Range 15W

Well Number #4 Foster "A"

Company Central Pet.

NORTH

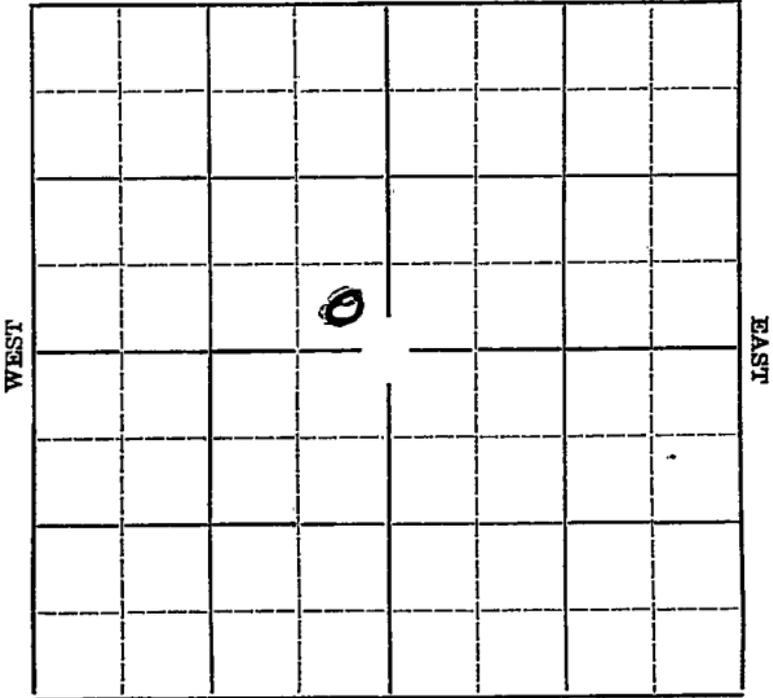

SOUTH

Map No. KANSAS Sec. 5 Twp. 14 R. 15W

Well No. #4 Foster "A" Farm


Central Pet. Company

_____ Ft. from N. Line

330' Ft. from S. Line

330' Ft. from E. Line

_____ Ft. from W. Line

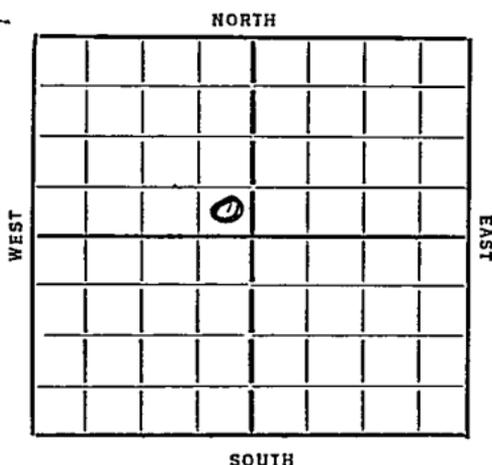

Date
1936

REPORT

6/3 Building rig.

6/11 Spud.

6/18 15" @ 345'. Drlg. 550'.

6/25 Anhy. 910'. Drlg. 1550'.

7/2 Drlg. 2510'.

7/9 Topeka 2760'. Show oil 2900-25'.

Drlg. 3000'.

7/16 Lansing 3034'. S.O. 3055-60'. Show oil 3070-72'. 2000 gallons of acid

7/22/36-Lansing 3034'. TD 3075'.

2000 gallons of acid.

4000 gallons of acid.

684 bbls of oil potential.

ABANDONED

KANSAS

Russell

Map No. 72 Sec. 3 Twp. 14 R. SW

Well No. 4 Foster A

Central P & O Company

Contractor

SECTION PLAT

	0		

_____ Ft. from N. Line

230 Ft. from S. Line

330 Ft. from E. Line

_____ Ft. from W. Line

FIRST REPORT

Location _____

Rig up _____

Drilling and Remarks:

Building rig

RECORD

Cased _____ in., _____ ft.

Sand _____

Gas _____

Oil _____

Total Depth _____

PRODUCTION

1st 24 hrs. Nat. _____

1st 24 hrs. after shot _____

Gas _____ Cu. Ft.

Dry Hole _____

Abandoned _____

Date

1 1930 19

S. J. LEWIS Scout

Map No. 72 Sec. 3 Twp. 14 R. 15W

Well No. 4 Foster

Central Company

Contractor

SECTION PLAT

_____ Ft. from N. Line

330 Ft. from S. Line

330 Ft. from E. Line

_____ Ft. from W. Line

COMP

Location _____

Rig up _____

Drilling and Remarks:

Leasing 3034.

2000 acid

4000 "

Pat 6848/6

RECORD

Cased _____ in., _____ ft.

Sand _____

Gas _____

Oil _____

Total Depth: 307.5

PRODUCTION

1st 24 hrs. Nat. _____

1st 24 hrs. after shot _____

Gas _____ Cu. Ft.

Dry Hole _____

Abandoned _____

Date

JUL 22 1936
19

S. J. LEWIS

Scout