


Russell

Section 3 Township 14 Range 15-W

Well No. 8 - Foster "B"

Company Central Petr.

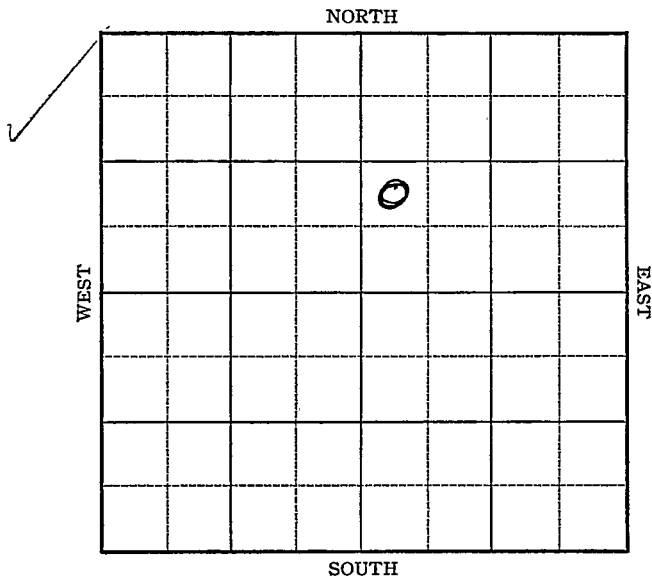

Sec. 3 Twp. 14 R. 15-W

Well No. #8 Foster "B" Farm

Central Petrô. Company


           Ft. from N. Line

990 Ft. from S. Line

           Ft. from E. Line

330 Ft. from W. Line

Elev. 1895

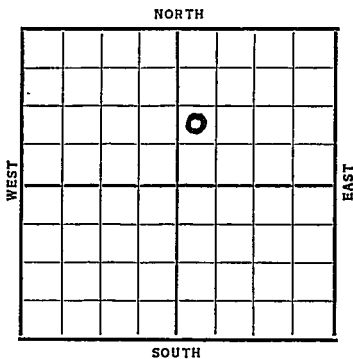

| Date  | REPORT                        |
|-------|-------------------------------|
| 1937  |                               |
| 9/1   | R. U. Cable Tools.            |
| 9/10  | 15" @ 400'. 12" @ 620'.       |
|       | Drlg. 650'.                   |
| 9/17  | Anhy 920'. 10" @ 930'.        |
|       | Drlg. 1795'.                  |
| 9/24  | Drlg. 2750'.                  |
| 10/2  | 8" @ 2776'. Dodge 3017'.      |
|       | K.C. 3053'. 7" @ 3055'.       |
|       | S.O. 3074-81'. Drlg. 3140'.   |
| 10/8  | H.F.W. 3130-35'. Sil. 3300'.  |
|       | 5" @ 3302'. No show reported. |
| 10/15 | Gorham 3306-09'. T.D. 3310'.  |
|       | 2500' oil 6 hrs. 100 shots    |
|       | with lane Wells guh 3306-09'. |
| 10/22 | " " " " "                     |
| 10/29 | " " " " "                     |
|       |                               |
|       |                               |
|       | <b>OVER</b>                   |
|       |                               |
|       |                               |

1937

11/3

5" @ 3302'.

Gorham 3306'.

T.D. 3310'.

100 shots Lane Wells gun 3306-09

Potential 1575 bbls.

COMPLETED

Russell KANSAS

Map No. 72 Sec. 3 Twp. 14 R. 15WWell No. 8-Foster "B"Central Petro Company

Contractor

## FIRST REPORT

## SECTION PLAT

11 Ft. from N. Line990 Ft. from S. Line

\_\_\_\_\_ Ft. from E. Line

330 Ft. from W. Line

|  |  |   |  |
|--|--|---|--|
|  |  |   |  |
|  |  | 0 |  |
|  |  |   |  |
|  |  |   |  |

Location \_\_\_\_\_

Rig up \_\_\_\_\_

Drilling and Remarks:

P. U. C. 7/16" Tool

## RECORD

Cased \_\_\_\_\_ in., \_\_\_\_\_ ft.

Sand \_\_\_\_\_

Gas \_\_\_\_\_

Soil \_\_\_\_\_

Total Depth \_\_\_\_\_

## PRODUCTION

1st 24 hrs. Nat. \_\_\_\_\_

1st 24 hrs. after shot \_\_\_\_\_

Gas \_\_\_\_\_ Cu. Ft.

Dry Hole \_\_\_\_\_

Abandoned \_\_\_\_\_

Date

SEP 1 1937 19

H. D. Hatfield Scout

Russell

KANSAS

Map No. \_\_\_\_\_ Sec. 3 Twp. 14 R. 15W

Well No. 8 Faster "B"

Central Petroleum Company

Contractor

**COMPLETED**

**NW SW NE**

**SECTION PLAT**

|  |  |   |  |
|--|--|---|--|
|  |  |   |  |
|  |  | 0 |  |
|  |  |   |  |
|  |  |   |  |

\_\_\_\_\_ Ft. from N. Line

990 Ft. from S. Line

\_\_\_\_\_ Ft. from E. Line

330 Ft. from W. Line

Location \_\_\_\_\_

Rig up \_\_\_\_\_

Drilling and Remarks:

*100 shots  
Lane wells gun  
3306-09*

*POT-1575*

**RECORD**

Cased 5 in., 3302 ft.

Sand Gorham 3306

Gas \_\_\_\_\_

Oil \_\_\_\_\_

Total Depth 3310

**PRODUCTION**

1st 24 hrs. Nat. \_\_\_\_\_

1st 24 hrs. after shot \_\_\_\_\_

Gas \_\_\_\_\_ Cu. Ft.

Dry Hole \_\_\_\_\_

Abandoned \_\_\_\_\_

Date

NOV 3 1927 19

H. D. Hatfield

Scout