
Form 51-5M-12-36 Com'l

Russell KANSAS

Section 3 Township 14 Range 15 - W

Well Number 6 - Foster "B"

Company Central Pet.

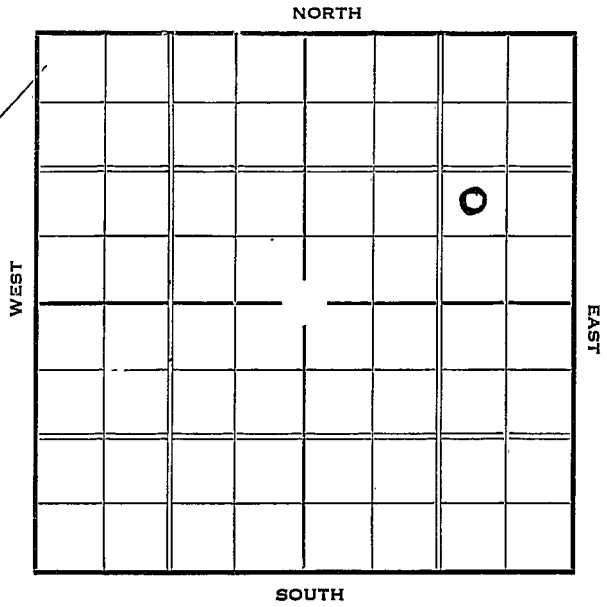


Form 252-A—5M—2-37—Palace KANSAS Russell

Sec. 3 Twp. 14 R. 15-W

Well No. #6 Foster "B" Farm

Central Pet. Company

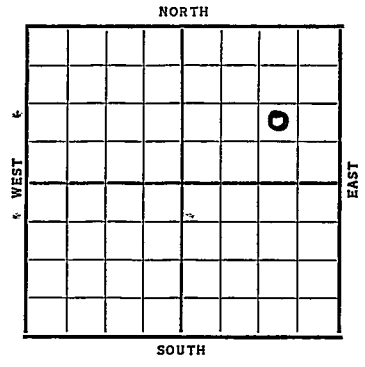

_____ Ft. from N. Line

990 Ft. from S. Line

990 Ft. from E. Line

_____ Ft. from W. Line

Elev. 1898

Date	REPORT
1937	
5/5	Rig on Gr.
5/14	Rig'n up
5/21	15" @ 370'. Drlg. 455'.
5/28	12" @ 620'. Anhy 925'.
	10" @ 935'. Drlg. 1945'.
6/4	8" @ 2610'. T.D. 2725'.
	U.R. 8".
6/11	Topeka 2760'. Dodge 3025'.
	Osw. 3058'. S.O. 3082-88'.
	6 B.W. per hr. 3145'.
	Drlg. 3240'.
6/19	5" @ 3304'. Drlg. 3306'.

OVER

1937

6/23 5" @ 3304'.

Gorham 3306'.

T.D. 3308'.

Pot. 2812 bbls. Nat.

COMPLETED

Form 26—1M Bks.—2-29 Russell KANSAS

Map No. 72 Sec. 3 Twp. 14 R. 15 W


Well No. 6 - Foster "B"

Central Pet. Company

Contractor

FIRST REPORT

SECTION PLAT

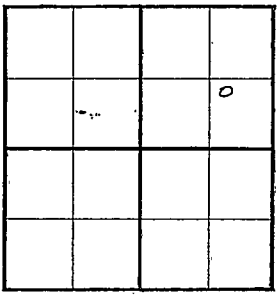

____ Ft. from N. Line

990 Ft. from S. Line

990 Ft. from E. Line

____ Ft. from W. Line

Location ____

Rig up ____

Drilling and Remarks:

Rig on gr.

RECORD

Cased ____ in., ____ ft.

Sand ____

Gas ____

Oil ____

Total Depth ____

PRODUCTION

1st 24 hrs. Nat. ____

1st 24 hrs. after shot ____

Gas ____ Cu. Ft.

Dry Hole ____

Abandoned ____

Date

MAY 5 - 1937

19 H. D. Hatfield Scout

Form 26—1M Bks.—2-29 Russell KANSAS

Map No. 72 Sec. 5 Twp. 14 R. 15W


Well No. 6—Foster "B"

Central Pet Company

Contractor

COMPLETED

SECTION PLAT

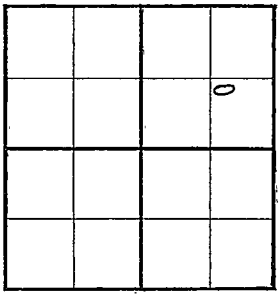

____ Ft. from N. Line

990 Ft. from S. Line

990 Ft. from E. Line

____ Ft. from W. Line

Location

Rig up

Drilling and Remarks:

Pot 2812

NAT

RECORD

Cased 5 in., 3304 ft.

Sand Gorham 3306

Gas

Oil

Total Depth 3308

PRODUCTION

1st 24 hrs. Nat.

1st 24 hrs. after shot

Gas Cu. Ft.

Dry Hole

Abandoned

Date

JUN 23 1937 19

H. D. Hatfield Scout