


Section.....3.....Township.....14.....Range.....15-W

Well Number.....11 - Foster "B".....

Company.....Central Pet.

NORTH

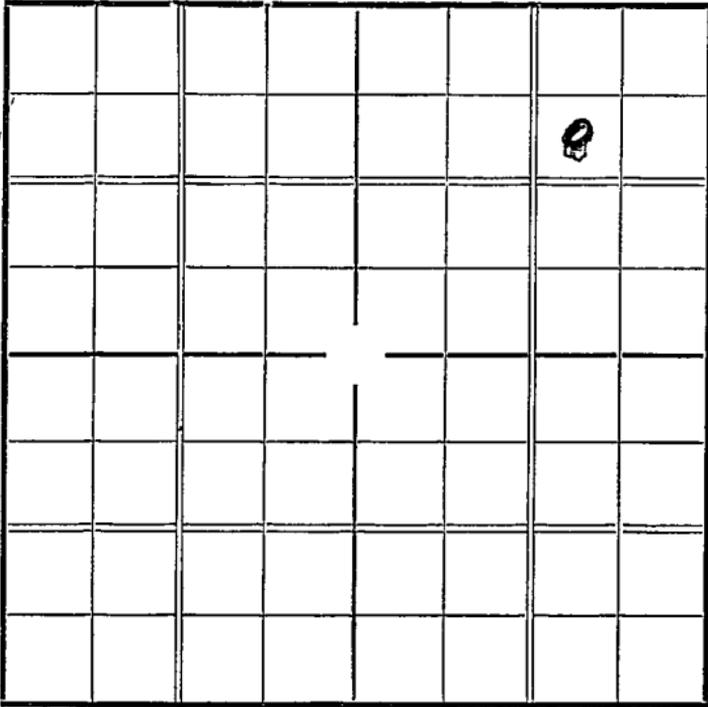

SOUTH

WEST

EAST

Sec. 3 Twp. 14 R. 15-W

Well No. #11 Foster "B" Farm
Central Pet. Company


990 Ft. from N. Line

 Ft. from S. Line

990 Ft. from E. Line

 Ft. from W. Line

Elev. 1901

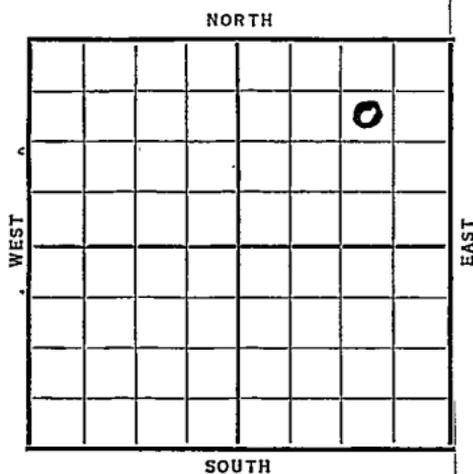

Date	REPORT
1937	
7/14	Cellar
7/23	Mat.
7/30	Cable rig.
8/6	" "
8/13	" "
8/20	" "
8/28	Spud.
9/3	15" @ 395'. 12" @ 624'. Anhy 927'. 10" @ 940'. Drlg. 1805'.
9/10	8" @ 2575'. Drlg. 2620'.
9/17	8" @ 2782'. S.O. 2782-85'. Oswald 3058'. 6" @ 3080' T.D.
	No shows reported.
9/24	Gorham 3310 & 5". WOC.

OVER

1937

9/29

5" @ 3310'.

Gorham 3310'.

T.D. 3315'.

Pot. 2268 bbls.

COMPLETED

KANSAS Russell

Map No. _____ Sec. 3 Twp. 14 R. 15 W.

Well No. 11-Foster "B"

Central Pet Company

Contractor

FIRST REPORT

SECTION PLAT

990 Ft. from N. Line

_____ Ft. from S. Line

990 Ft. from E. Line

_____ Ft. from W. Line

			0

Location _____

Rig up _____

Drilling and Remarks:

cellar

RECORD

Cased _____ in., _____ ft.

Sand _____

Gas _____

Oil _____

Total Depth _____

PRODUCTION

1st 24 hrs. Nat. _____

1st 24 hrs. after shot _____

Gas _____ Cu. Ft.

Dry Hole _____

Abandoned _____

Date

JUL 14 1937 19

H. D. Hatfield

Scout

Russell **KANS**

Map No. _____ Sec. 3 Twp. 14 R. 1

Well No. 11-Foster "p"
Central Petrol Co. _____

Contr. _____

COMPLETED

SW NE NE

SECTION PLAT

990 Ft. from N. Line

_____ Ft. from S. Line

990 Ft. from E. Line

_____ Ft. from W. Line

			0

Location _____

Rig up _____

Drilling and Remarks:

Pat - 2268

RECORD

Cased 5 in., 3310 ft.

Sand Gerham 3310

Gas _____

Oil _____

Total Depth 3315

PRODUCTION

1st 24 hrs. Nat. _____

1st 24 hrs. after shot _____

Gas _____ Cu. Ft.

Dry Hole _____

Abandoned _____

Date

SEP 29 1937

19

H. D. Hatfield Scout