


Company.....Central Pet.

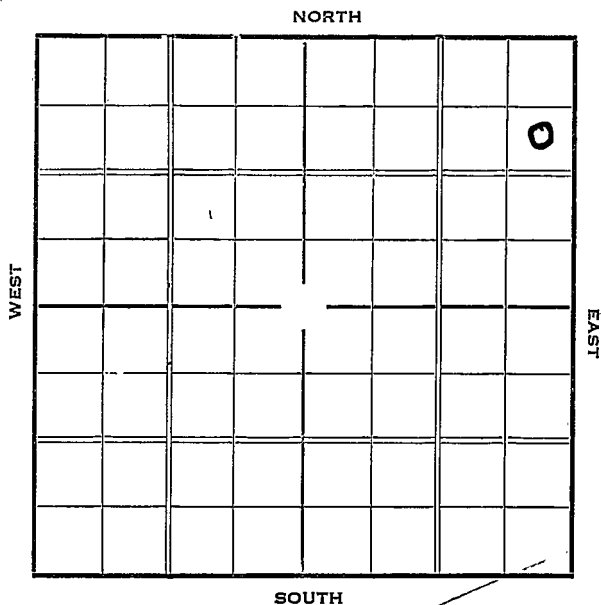

1937

7/14

6" @ 3302'.

Gorham 3302'.

T.D. 3304'.

Pot. 2352 bbls.

COMPLETED

Russell

KANSAS

Map No. 72 Sec. 3 Twp. 14 R. 15^WWell No. 12 - Foster "B"Central Pet Company

Contractor

FIRST REPORT

990 Ft. from N. Line Ft. from S. Line330 Ft. from E. Line Ft. from W. Line

SECTION PLAT

			0

Location Rig up

Drilling and Remarks:

mov. in Rig

RECORD

Cased in., ft.Sand Gas Oil Total Depth

" PRODUCTION

1st 24 hrs. Nat. 1st 24 hrs. after shot Gas Cu. Ft.Dry Hole Abandoned

Date

MAY 19 1937 ₁₉

H. D. Hatfield

Scout

Russell KANSAS

Map No. _____ Sec. 3 Twp. 14 R. 15^WWell No. 12 - Foster "B"Central Pet Company

Contractor _____

COMPLETED

990 Ft. from N. Line1 Ft. from S. Line330 Ft. from E. Line

_____ Ft. from W. Line

SECTION PLAT

			0

Location _____

Rig up _____

Drilling and Remarks:

RECORD

Cased 6 in. 3302 ft.Sand Gorham 3302

Gas _____

Oil _____

Total Depth 3304

PRODUCTION

1st 24 hrs. Nat. _____

1st 24 hrs. after shot _____

Gas _____ Cu. Ft.

Dry Hole _____

Abandoned _____

Date

JUL 14 1937

H. D. Hatfield

19

Scout