

# KANSAS


FORM 51 5M 4-41 PETROL

Section 3 Township 14 Range 15-W

Well No. #15 Foster "B"

Company Central Petroleum  
(Gorham)

NORTH

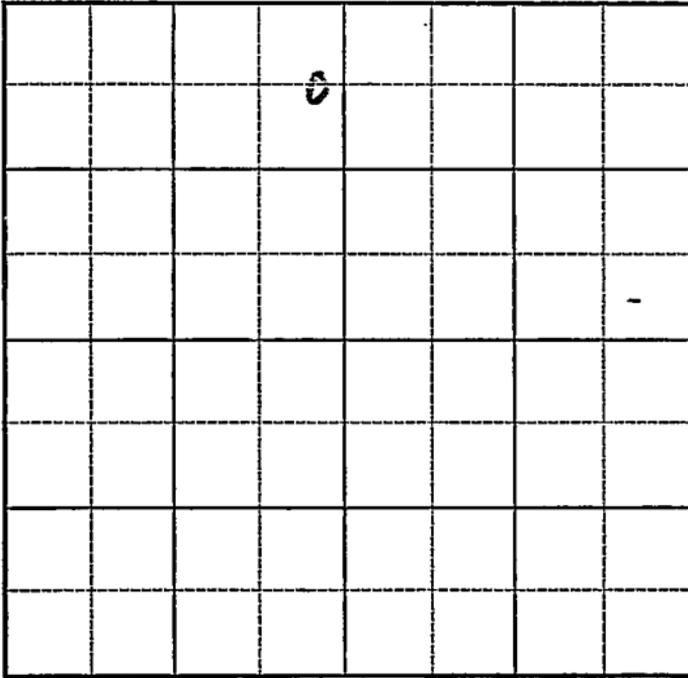

SOUTH



Sec. 3 Twp. 14 R. 15-W

Well No. #15 Foster "B" Farm

Central petroleum Company

(Gorham Pool)


660 Ft. from N. Line

\_\_\_\_\_ Ft. from S. Line

330 Ft. from E. Line

\_\_\_\_\_ Ft. from W. Line

Elev. 1898

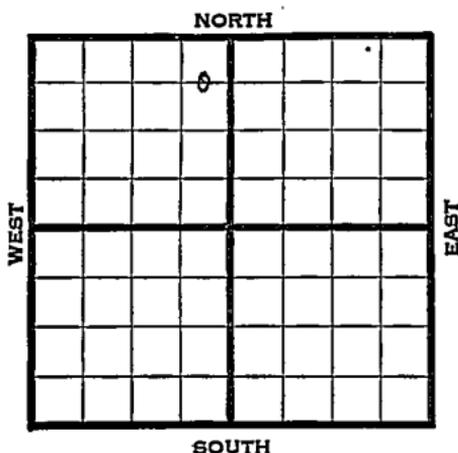

1941	REPORT
8/6	8" - 933'
	Drlg. 2045'
8/15	Gorham 3307 3305'
	T.D. 3310
	5" @ 3310 RUST
8/21	Gorham 3305' (Corrected)
	5" - 3308' T.D. 3312' 3000' oil
	6 hours.
8/27	" "
9/4	Shut down.
9/10	Gorham 3305'
	5" - 3308'
	T.D. 3312'
	Potential 416 bbls., pump.
	36.5 Gravity
	<b>COMPLETED</b>

**KANSAS**Map No. \_\_\_\_\_ Sec. 3 Twp. 14 R. 15WWell No. 15 Foster "B"

\_\_\_\_\_ Central Petroleum \_\_\_\_\_ Company

\_\_\_\_\_ **FIRST REPORT** \_\_\_\_\_ Contractor**SECTION PLAT**

C E L NE NW

660 Ft. from N. Line

\_\_\_\_\_ Ft. from S. Line

330 Ft. from E. Line

\_\_\_\_\_ Ft. from W. Line


GORHAM POOL

**RECORD**

Location \_\_\_\_\_

Cased \_\_\_\_\_ in., \_\_\_\_\_ ft.

Rig up \_\_\_\_\_

Sand \_\_\_\_\_

Drilling and Remarks:

Gas \_\_\_\_\_

8" - 933

Oil \_\_\_\_\_

Total Depth \_\_\_\_\_

Drlg. 2045

**PRODUCTION**

1st 24 hrs. Nat. \_\_\_\_\_

1st 24 hrs. after shot \_\_\_\_\_

Gas \_\_\_\_\_ Cu. Ft.

Dry Hole \_\_\_\_\_

Abandoned \_\_\_\_\_

Date

AUG 6 1941 19

S. J. LEWIS Scout

Map No. \_\_\_\_\_ Sec. 3 Twp. 14 R. 15WWell No. 15 Foster "B"Central Petroleum CompanyCOMPLETED Contractor

C E L NE NW

660 Ft. from N. Line

\_\_\_\_\_ Ft. from S. Line

330 Ft. from E. Line

\_\_\_\_\_ Ft. from W. Line

GORHAM POOL

## SECTION PLAT

	o		

## RECORD

Location \_\_\_\_\_

Cased \_\_\_\_\_ in., \_\_\_\_\_ ft.

Rig up \_\_\_\_\_

Sand \_\_\_\_\_

Drilling and Remarks:

Gas \_\_\_\_\_

Oil \_\_\_\_\_

Total Depth 33125" 103308Pump 4/16 P.S.F.

## PRODUCTION

1st 24 hrs. Nat. \_\_\_\_\_

1st 24 hrs. after shot \_\_\_\_\_

Gas \_\_\_\_\_ Cu. Ft.

Dry Hole \_\_\_\_\_

Abandoned \_\_\_\_\_

36 5 Gr

Date

SEP 10 1941 19S. J. LEWIS Scout