


Section 3 Township 14 Range 15-W

Well Number 4 - A - Witt (Twin Well)

Company A. H. Witt

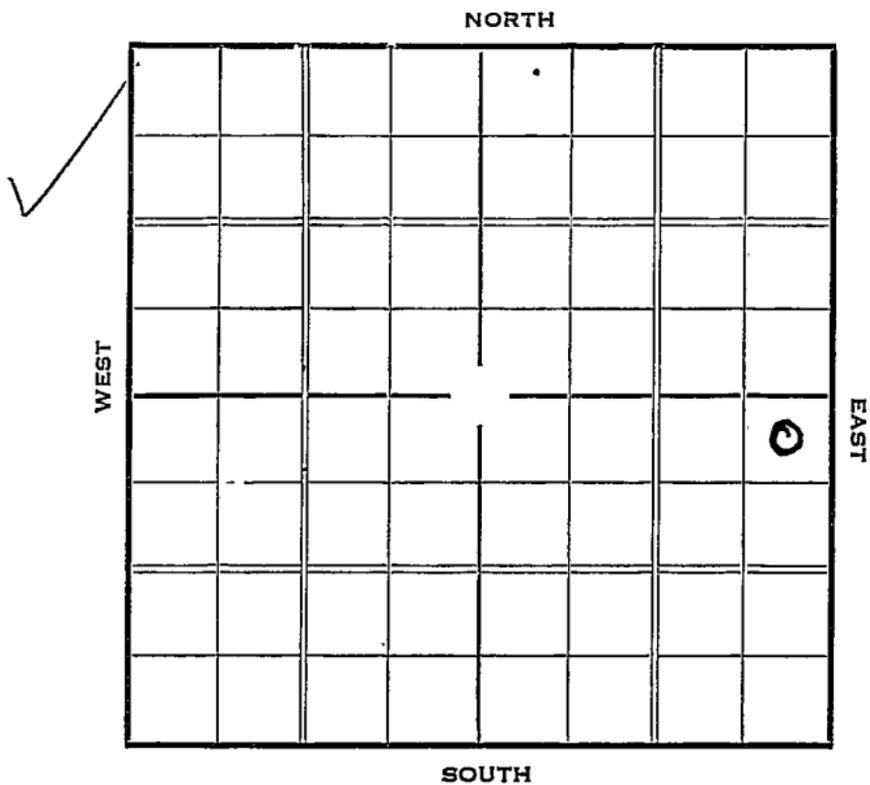

Sec. 5 Twp. 14 R. 15-W

Well No. #4-A Witt (Twin Well) Farm

A. H. Witt Company


380 Ft. from N. Line

_____ Ft. from S. Line

330 Ft. from E. Line

_____ Ft. from W. Line

Elev. 1879

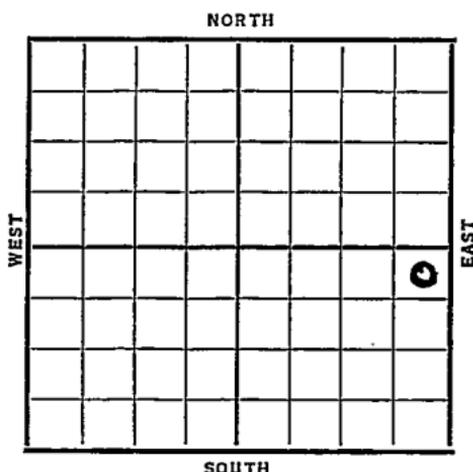

Date	REPORT
1937	
5/5	Cable rig.
5/14	Rig'n up
5/21	Drlg. 350'.
5/28	15" @ 389'. 12" @ 615'.
	Anhy 910'. 10" @ 921'.
	Drlg. 930'.
6/4	Drlg. 1920'.
6/11	8" @ 2563'. Topeka 2725'.
	U. R. 8".
6/19	8" @ 2770' T.D. WOC.
6/25	Drlg. 3015'.
7/2	Oswald 3050'. 6" @ 3054'.
	Pay 3060-63'. 1500' oil.
	5000 acid. T.D. 3094'.
	OVER

1937

7/7

6" @ 3054'.

Osw. 3050'.

Pay 3060-63'.

T.D. 3094'.

5000 A

Pot. 2367 bbls.

COMPLETED

Russell **KANSAS**

Map No. 72 Sec. 3 Twp. 14 R. 15^w

Well No. 4-A-witt (Twin Well)

A. H. Witt Company

Contractor

FIRST REPORT

SECTION PLAT

380 Ft. from N. Line
 _____ Ft. from S. Line
330 Ft. from E. Line
 _____ Ft. from W. Line

			0

Location _____

Rig up _____

Drilling and Remarks:

Cable Rig

RECORD

Cased _____ in., _____ ft.

Sand _____

Gas _____

Oil _____

Total Depth _____

PRODUCTION

1st 24 hrs. Nat. _____

1st 24 hrs. after shot _____

Gas _____ Cu. Ft.

Dry Hole _____

Abandoned _____

Date

MAY 5 - 1937

19

A. H. Witt Secut.

Russell KANSAS

Map No. _____ Sec. 3 Twp. 14 R. 15^wWell No. 4-A-witt (Twin well)A. H. Witt Company

Contractor

COMPLETED**SECTION PLAT**

			0

580 Ft. from N. Line

_____ Ft. from S. Line

330 Ft. from E. Line

_____ Ft. from W. Line

Location _____

Rig up _____

Drilling and Remarks:

5000 APart = 2367**RECORD**Cased 6 in., 3054 ft.Sand Qsw, 3050Gas Pay 3060-63

Oil _____

Total Depth 3094**PRODUCTION**

1st 24 hrs. Nat. _____

1st 24 hrs. after shot _____

Gas _____ Cu. Ft.

Dry Hole _____

Abandoned _____

Date

JUL 7 1937₁₉H. D. Hatfield Scout