


Section 3 Township 14 Range 15-W

Well No. #16 Foster "B"

Company Central Petroleum

NORTH Gorham Pool

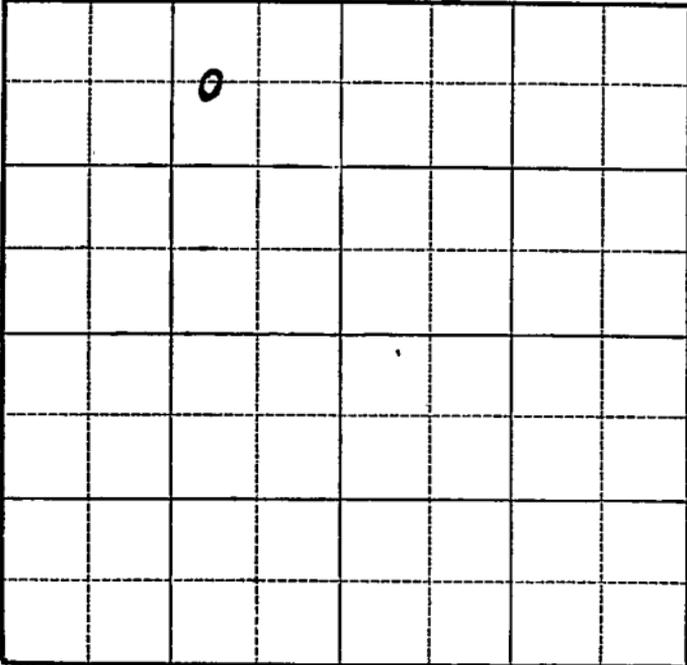

SOUTH



Sec. 3 Twp. 14 R. 15-W

Well No. #16 Foster "B" Farm

Central Petr. Company

(Gorham)


660 Ft. from N. Line

_____ Ft. from S. Line

990 Ft. from E. Line

_____ Ft. from W. Line

Elev. 1893

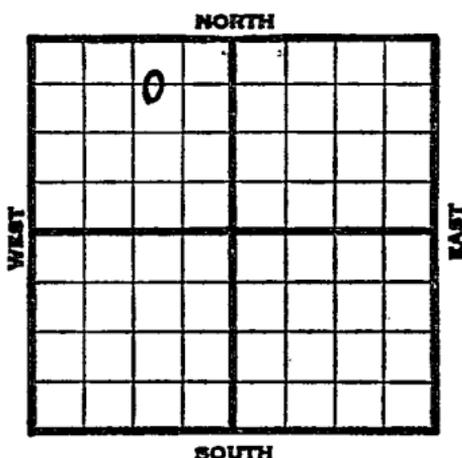

1940	REPORT
2/14	Pits.
2/23	R.U. Cable.
2/29	Shut down.
3/8	" "
3/14	20" - 26' 15" - 380'
	12" - 615' Drlg. 850'
3/21	Anhy 915' 10" - 928'
	Drlg. 1775'
3/28	8" - 2545' T.D. 2575' UR 8".
4/4	S.O. 2765' 8" - 2770'
	S.O. 2960-80' TD 3044' SD.
4/12	6" - 3059' Lansing 3071'
	Water 3090-3100' Wtr. 3170-80'
	5½" - 3260' Drlg. 3285'
4/18	Gorham 3303' 5" - 3303'
	T.D. 3311' H.F.O.
	OVER

1940
4/24

Gorham 3303'

5" - 3303'

T.D. 3311'

Potential 1572 bbls., pump.

COMPLETED

Map No. 72 Sec. 3 Twp. 14 R. 15W

Well No. 16 Foster "B"

Central Petroleum Company

Contractor

FIRST REPORT

C W L NE NW

SECTION PLAT

	o		

660 Ft. from N. Line

_____ Ft. from S. Line

990 Ft. from E. Line

_____ Ft. from W. Line

Gorham Pool

Location _____

Rig up _____

Drilling and Remarks:

Pits

RECORD

Cased _____ in., _____ ft.

Sand _____

Gas _____

Oil _____

Total Depth _____

PRODUCTION

1st 24 hrs. Nat. _____

1st 24 hrs. after shot _____

Gas _____ Cu. Ft.

Dry Hole _____

Abandoned _____

Date

FEB 1 ± 1940 19

S. J. LEWIS Scout

Map No. 72 Sec. 3 Twp. 14 R. 15WWell No. 16 Foster "B"Central Petroleum Company

Contractor

COMPLETED

C W L NE NW

660 Ft. from N. Line

_____ Ft. from S. Line

990 Ft. from E. Line

_____ Ft. from W. Line

GORHAM POOL

SECTION PLAT

	0		

Location _____

Rig up _____

Drilling and Remarks:

*Goz kam 3303**5" @ 3303**Pump 1572 BX.*

RECORD

Cased _____ in., _____ ft.

Sand _____

Gas _____

Oil _____

Total Depth 3311

PRODUCTION

1st 24 hrs. Nat. _____

1st 24 hrs. after shot _____

Gas _____ Cu. Ft.

Dry Hole _____

Abandoned _____

Date

APR 24 1940 19S. J. LEWIS Scout