


Section 3 Township 14 Range 15-WWell Number #4 "B" WittCompany Bridgeport

(Twin #4)

NORTH

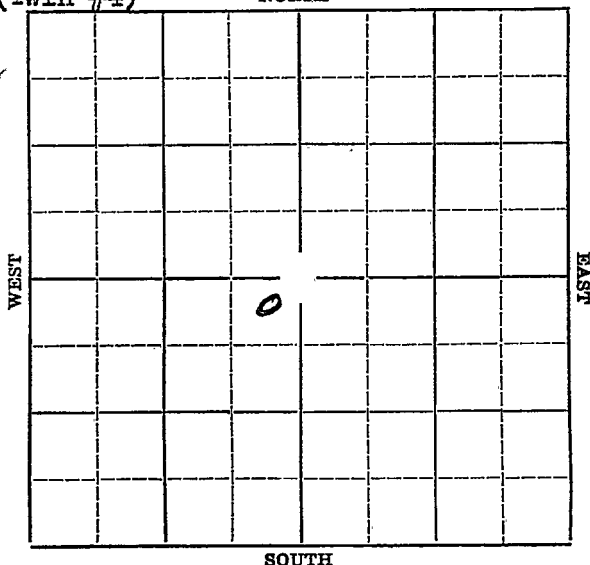

1936

11/4- Sil. 3295

Granite 3310

T. D. 3315

P. B. 3100

Pot. 414 Bbls. show water

COMPLETED

KANSAS

Map No. 72 Sec. 3 Twp. 14 R. 15WWell No. 4 "B" W. TtBridgport CompanyJ. J. Lewis ContractorTwin No 4300 Ft. from N. Line Ft. from S. Line300 Ft. from E. Line Ft. from W. Line

SECTION PLAT

	0		

FIRST REPORT

Location Rig up

Drilling and Remarks:

Cellar

RECORD

Cased in., ft.Sand Gas Oil Total Depth

PRODUCTION

1st 24 hrs. Nat. 1st 24 hrs. after shot Gas Cu. Ft.Dry Hole Abandoned

Date

AUG 26 1936 19 S. J. LEWIS Scout

Map No. 72 Sec. 3 Twp. 14 R. 15W

Well No. 4 B. With

Bridgeport Company

[Signature] Contractor

SECTION PLAT

	0		

300 Ft. from N. Line

_____ Ft. from S. Line

300 Ft. from E. Line

_____ Ft. from W. Line

COMPLETED

Location _____

Rig up _____

Drilling and Remarks:

Oil 3295

Granite 3310

P.B. 3100

Prod 41488h.

show water

RECORD

Cased _____ in., _____ ft.

Sand _____

Gas _____

Oil _____

Total Depth 3315

PRODUCTION

1st 24 hrs. Nat. _____

1st 24 hrs. after shot _____

Gas _____ Cu. Ft.

Dry Hole _____

Abandoned _____

Date

NOV 4 1936 19

S. J. LEWIS Scout