




Russell

Map No. KANSAS Sec. 3 Twp. 14 R. 15W

Well No. #1 Witt Farm  
Bridgeport Machine Company

330 Ft. from N. Line  
\_\_\_\_ Ft. from S. Line  
\_\_\_\_ Ft. from E. Line  
330 Ft. from W. Line

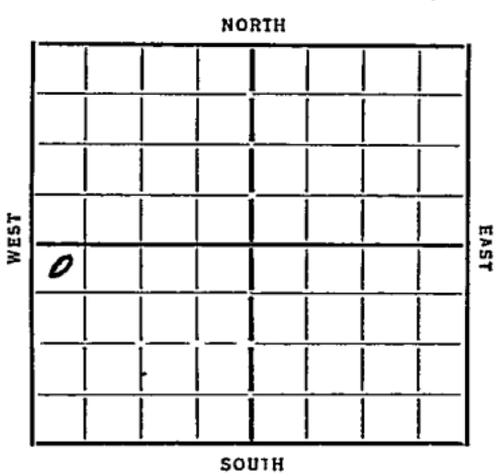

Date 1935

REPORT

2/27 Cellar  
3/7 M.O.P.  
3/14 \_\_\_\_\_  
3/21 Bldg.  
3/28 ~~4/4~~  
4/11 dly 670 15" 380 12" 585  
4/18 10" 917 Auger 913 dly 1650  
4/26 2510 run 18"  
5/2 dly 2770 8" 2700 502760  
5/9 8" 2774 6" 3030 oil 3055  
5/5 T 7 3105 2000' oil  
oil 3055 T 7 3105  
2000 acid  
1136 Bbls.

COMPLETED

Map No. 72 Sec. 3 Twp. 14 R. 15W

Well No. 1- Witt

Bridgport Machine Company

Contractor

FIRST REPORTS

330 Ft. from N. Line

..... Ft. from S. Line

..... Ft. from E. Line

330 Ft. from W. Line

SECTION PLAT

0			

Location.....

Rig up.....

Drilling and Remarks:

*cellar*

RECORD

Cased..... in., ..... ft.

Sand.....

Gas.....

Oil.....

Total Depth.....

PRODUCTION

1st 24 hrs. Nat.....

1st 24 hrs. after shot.....

Gas..... Cu. Ft.

Dry Hole.....

Abandoned.....

Date

ORVAL MANNSCHRECK

2-27-35 192.....

Scout

Map No. 72 Sec. 3 Twp. 14 R. 15W

Well No. 1-Witt

Bridgport Company

Contractor

SECTION PLAT

330 Ft. from N. Line ~~COMPLETED~~  
..... Ft. from S. Line  
..... Ft. from E. Line  
330 Ft. from W. Line

0			

Location.....

Rig up.....

Drilling and Remarks:

2000 and

1136 lbs

RECORD

Cased..... in., ..... ft.

Sand.....

Gas.....

Oil 3055

Total Depth 3105

PRODUCTION

1st 24 hrs. Nat.....

1st 24 hrs. after shot.....

Gas..... Cu. Ft.

Dry Hole.....

Abandoned.....

Date 5-15-35 192.....

ORVAL MANNSCHECK

Scout