

KANSAS

Form 51—5M—7-40—Palace

Russell

Section 3 Township 14 Range 15-W

Well No. #1-A Foster "B"

Company Central Petroleum


NORTH

Gorham Pool

WEST

EAST

SOUTH

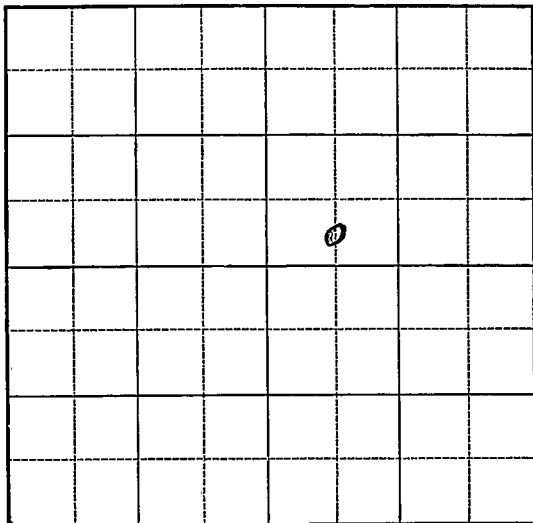


Sec. 3 Twp. 14 R. 15-WWell No. #1-A Foster "B" FarmCentral Petr. Company

(Gorham)

 Ft. from N. Line330 Ft. from S. Line Ft. from E. Line660 Ft. from W. Line

Elev. 1892

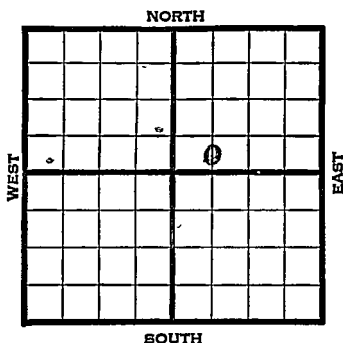

1940	REPORT
12/4	Ponds.
12/12	Cable rigging up.
12/19	" " "
12/26	" " "
1941	
1/2	Shut down.
1/9	" "
1/16	" "
1/23	15" - 410' Drlg. 565'
1/30	12" - 625' 10" - 940'
	Drlg. 1595'
2/6	Drlg. 2470'
2/13	Topeka 2774' 8" - 2769'
	Drlg. 2890'
2/20	Dodge 3015' Show oil 3030-35'
	Lans. 3050' T.D. 3071'
	5" - 3070' Drlg. cement.
2/27	S.O. 3075-80' Pay 3083-86 &
	3130-35' T.D.
3/6	Shut down.
	OVER

1941
3/13

T.D. 3137' 1100' oil.
1500 acid.

3/19

Lans. 3050'

5" - 3070'

T.D. 3137'

1500 acid.

Potential 692 bbls., pump.

36.5 Gravity

COMPLETED

Map No. 72 Sec. 3 Twp. 14 R. 15WWell No. 1-A Foster "B"Central Petroleum Company


Contractor

FIRST REPORT

C S L SW NE

 Ft. from N. Line330 Ft. from S. Line Ft. from E. Line660 Ft. from W. Line

GORHAM POOL

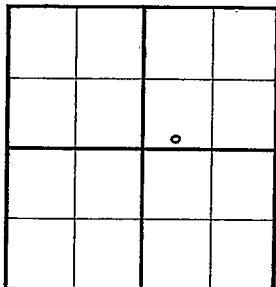SECTION PLATLocation Rig up

Drilling and Remarks:

Ponds

RECORDCased in., ft.Sand Gas Oil Total Depth **PRODUCTION**1st 24 hrs. Nat. 1st 24 hrs. after shot Gas Cu. Ft.Dry Hole Abandoned

Date

DEC 4 1940 19

S. J. LEWIS Scout

Misc. Small Maps	RAM
Cards	RAM
Tracing	JM
France Map	RAM
Contribution Map	RAM
Money Map	JM
Geographical Dept.	
Money 1st Book	

Map No. 72 Sec. 3 Twp. 14 R. 15WWell No. 1-A Foster "B"Central Petroleum CompanyCOMPLETE Contractor

C S L SW NE

 Ft. from N. Line330 Ft. from S. Line Ft. from E. Line660 Ft. from W. Line

GORNAM POOL

SECTION PLAT

Location Rig up

Drilling and Remarks:

*Li and 8050**5" 8050**1500 acid**Pump. 692 Pot.**36.5 Gr*

RECORD

Cased in., ft.Sand Gas Oil Total Depth 3137

PRODUCTION

1st 24 hrs. Nat. 1st 24 hrs. after shot Gas Cu. Ft.Dry Hole Abandoned

Date

MAR 19 1941 19

S. J. LEWIS Scout

Misc Small Maps	DAV
Cards	Jan
Tracing	Jan
France Map	DAV
