


Section 3 Township 14 Range 15-W

Well No. 5 - C. Foster "B" Twin #5

Company Central Pet.

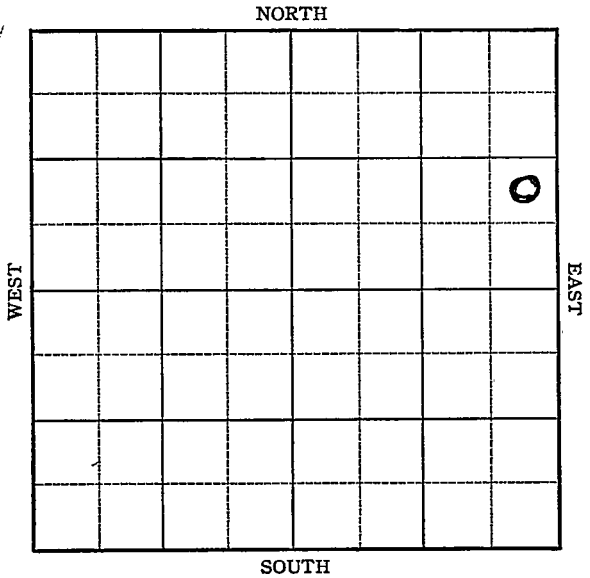

Sec. 3 Twp. 14 R. 15-W

Well No. #5-C Foster "B" Farm

Central Pet. Company


 Ft. from N. Line

990 Ft. from S. Line

390 Ft. from E. Line

 Ft. from W. Line

Twin #5

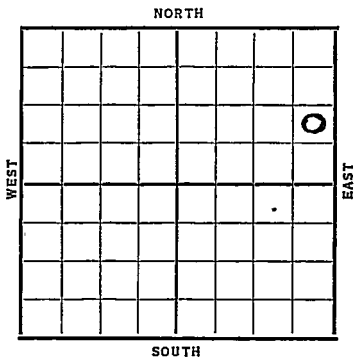

Date	Elev. 1888	REPORT
1937		
9/15	B.C.R.	
9/24	"	
10/2	15" @ 390'	Drlg. 600'
10/8	12" @ 655'	Anhy 920'
	10" @ 945'	Drlg. 1750'
10/15	8" @ 2571'	T.D. 2605'
	U.R. 8"	
10/22	SD 3100'	
10/29	" "	
11/3	6" @ 3094'	
	300' of 5" liner 3299'	
	Gorham 3299'	
	T.D. 3304'	
	Potential 2268 bbls.	
	COMPLETED	

Russell KANSAS

Map No. _____ Sec. 3 Twp. 14 R. 15^W

Well No. 5-C-Foster "B" TWIN #5

Central Pet. Company

Contractor

FIRST REPORT

SECTION PLAT

_____ Ft. from N. Line

990 Ft. from S. Line

390 Ft. from E. Line

_____ Ft. from W. Line

			0

Location _____

Rig up _____

Drilling and Remarks:

B.C.R.

RECORD

Cased _____ in., _____ ft.

Sand _____

Gas _____

Oil _____

Total Depth _____

PRODUCTION

1st 24 hrs. Nat. _____

1st 24 hrs. after shot _____

Gas _____ Cu. Ft.

Dry Hole _____

Abandoned _____

Date

SEP 15 1937 19

H. D. Hatfield Scout

Russell **KANSAS**

Map No. _____ Sec. 3 Twp. 14 R. 15W

Well No. 5 "C" Foster "B" (Twin#5)

Central Petroleum Company

Contractor

COMPLETED

NE SE NE

SECTION PLAT

			0

_____ Ft. from N. Line

990 Ft. from S. Line

390 Ft. from E. Line

_____ Ft. from W. Line

Location _____

Rig up _____

Drilling and Remarks:

POT-2268

6" 3094
RECORD
300' of 5" liner 3299
 Cased _____ in., _____ ft.
 Sand *Gorham 3299*
 Gas _____
 Oil _____
 Total Depth *3304*

PRODUCTION

1st 24 hrs. Nat. _____
 1st 24 hrs. after shot _____
 Gas _____ Cu. Ft.
 Dry Hole _____
 Abandoned _____

Date

NOV 3 1937 19

H. D. Hatfield Scout