


Section 30 Township 14 Range 29W

Well No. #1 Sundgren

Company Argo Oil

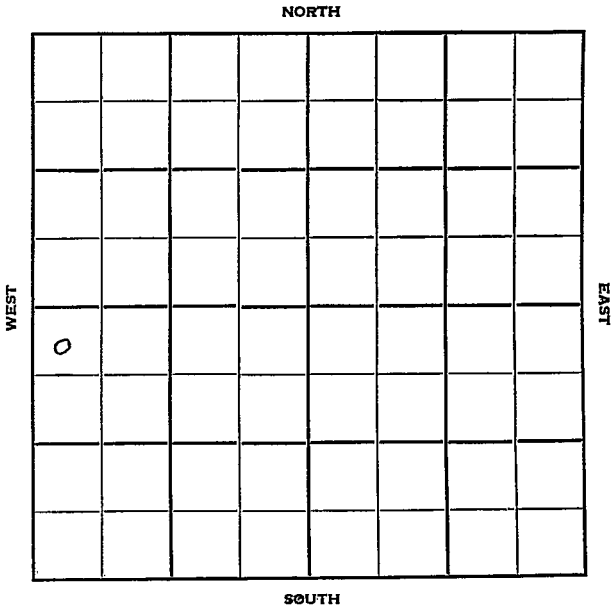

Sec. 30 Twp. 14 R. 29W

Well No. #1 Sundgren Farm

Argo Oil Company

Semi Wildcat Contractor


330 Ft. from N. Line

_____ Ft. from S. Line

_____ Ft. from E. Line

330 Ft. from W. Line

NW NW SW

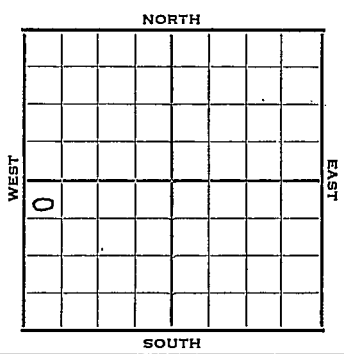

1952

Elev. 2628'

REPORT

6/25

Spud 6-20-52
8" @ 154'
Anhy 1980'
Drlg. 2529'

7/2

Drlg. 3758' in KC

7/9

Lans. 3705
DST 4283-4313 1 hr. 15' M
Miss 4281
DST 4313-23 1 hr. 35' OCM
900# DST 4338-50

7/16

Spud 6-20-52
D & A TD 4400' 8" @ 154'
Anhy 1980' Lans. 3705'
DST 4283-4313 open 1 hr. rec 15' mud
825# Miss 4281'
DST 4313-23 open 1 hr. rec 35' OCM
900#
DST 4338-50 open 1 hr. rec 100' VSOCM
1000#
DST 4363-4370 open 1 hr. rec 50' mud
TD 4400'
D & A

ABANDONED

County Gove State Kansas

Sec. 30 (Blk. 14) (Sur. Rge.) 29W Map No.

Operator Argo Oil

Well No. 1 Farm Sundgren

Elev. 2628 Location NW NW SW

| | | | | | |
|---|------------------|--|--|--|--|
| | | | | | |
| | | | | | |
| | | | | | |
| | | | | | |
| 0 | ABANDONED | | | | |
| | | | | | |
| | | | | | |
| | | | | | |

330 Ft. From N Line SW

330 Ft. From W Line Quarter

1st. Report

Completion JUL 16 1952

Remarks Semi Wildcat

Spudding Date 6-20-52

Drlg. Data D & A TD 4400

8" @ 154 Anhy 1980 Lans. 3705

DST 4283-4313 open 1 hr. Rec. 15' mud

825# Miss. 4281 DST 4313-23 open 1 hr.

Rec. 35' ocm 900# DST 4338-50

open 1 hr. Rec. 100' vsocm 1000#

DST 4363-4370 open 1 hr. Rec. 50' mud

TD 4400

D & A

J. G. McGEHEE