

KANSAS


FORM 51 5M 1-42 PETROL

Russell

Section 30 Township 14 Range 14~~W~~

Well No. 2 Brandenberg

Company Phillips

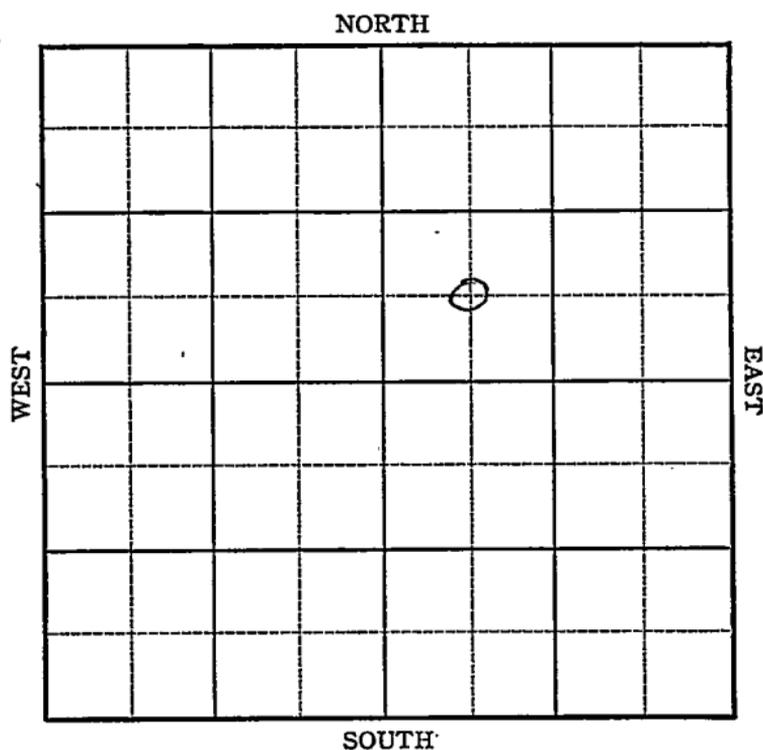

Sec. 30 Twp. 14 R. 14

Well No. #2 Brandenburg Farm

Phillips Company


_____ Ft. from N. Line

660 Ft. from S. Line

_____ Ft. from E. Line

660 Ft. from W. Line

Elev. 1791

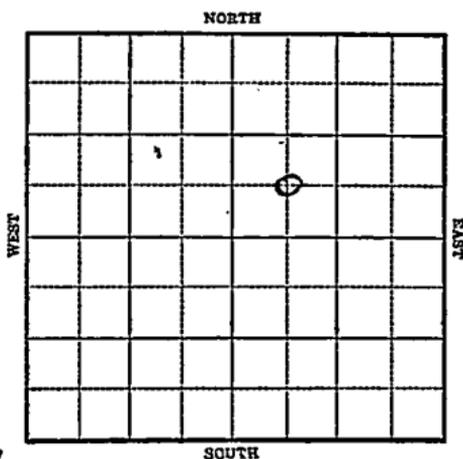

1943

R E P O R T

11/17

Rotary

11/24

"

12/1

8" @ 605'

Drlg. 650'

12/8

Drlg. 2530'

12-15

Lans 2976'

Arb 3217'

TD 3227'

SD

12/22

Arb 3217

No shows

TD 3227

~~ABANDONED~~

KANSAS

Map No. 72 Sec. 30 Twp. 14 R. 14W

Well No. 2 **Brandenberg**

Phillips Company

FIRST REPORT Contractor

C SW NE

_____ Ft. from N. Line

660 Ft. from S. Line

_____ Ft. from E. Line

660 Ft. from W. Line

SECTION PLAT

		o	

Hall-Gurney Pool

Location _____

Rig up _____

Drilling and Remarks:

Rotary

RECORD

Cased _____ in., _____ ft.

Sand _____

Gas _____

Oil _____

Total Depth _____

PRODUCTION

1st 24 hrs. Nat. _____

1st 24 hrs. after shot _____

Gas _____ Cu. Ft.

Dry Hole _____

Abandoned _____

Date

NOV 17 1943 19

S. J. LEWIS Scout

Map No. KANSAS Sec. 30 Twp. 14 R. 14 W

Well No. 2 Brandenburg

Phillips Company

ABANDONED Contractor

C SW NE

SECTION PLAT

_____ Ft. from N. Line

660 Ft. from S. Line

_____ Ft. from E. Line

660 Ft. from W. Line

		o	

Hall-Gurney Pool

Location _____

Rig up _____

Drilling and Remarks:

See 80217

Noe hore

RECORD

Cased _____ in., _____ ft.

Sand _____

Gas _____

Oil _____

Total Depth 3227

PRODUCTION

1st 24 hrs. Nat. _____

1st 24 hrs. after shot _____

Gas _____ Cu. Ft.

Dry Hole _____

Abandoned _____

Date

DEC 22 1943 19

S. J. LEWIS Scout