
Russell KANSAS

FORM 51 25M 3-49 PETROL

Section 30 Township 14 Range 14W

Well No. #6 Ehrlich

Company Cities Service

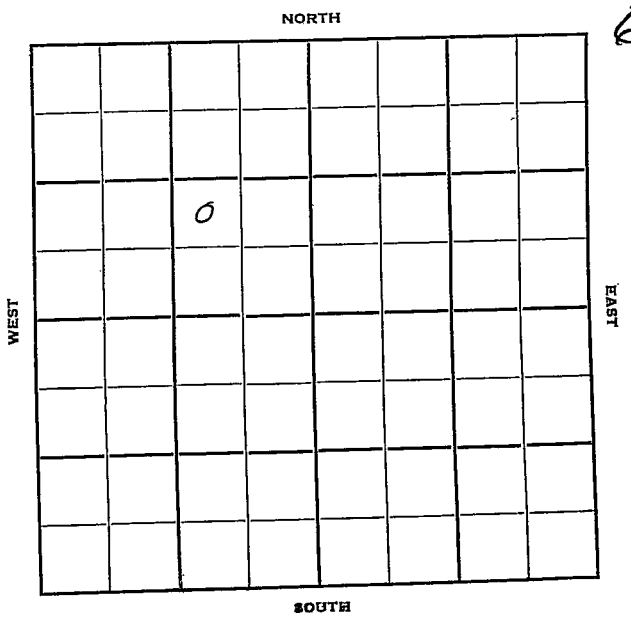

FORM 252-B
10M 9-49 PETROL

Russell KANSAS

Sec. 30 Twp. 14 R. 14W

Well No. #6 Ehrlich Farm

Cities Service Company

Contractor

Big Creek Pool

NORTH

WEST EAST

SOUTH

Ft. from N. Line

990' Ft. from S. Line

990' Ft. from E. Line

Ft. from W. Line

NW SE NW

1950	Elev 1822 REPORT
8/30	Location
10/4	Spud 9-2-50 8" @ 600 Heeb 2943 Lans 3006 Arb 3244-46 5" @ 3245 TD 3246 FU 300' oil 1 hr 930' oil 15 hr P/15 bo 12 hr 500 A P/137 bo Comp 137 bo 127 bwpd Completed COMPLETED

FORM 275 FOR SALE BY KANSAS BLUE PRINT CO.


County Russell State Kansas

Sec. 30 (Blk. Twp.) 14 (Sur. Rge.) 14W Map No.

Operator Cities Service

Well No. 6 Farm Ehrlich

Elev. Location NW SE NW

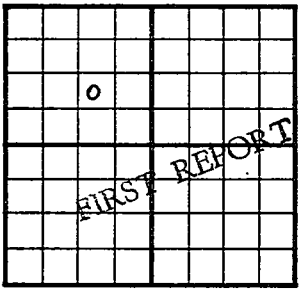

990 Ft. From S Line NW

990 Ft. From E Line Quarter

1st. Report AUG 30 1950

Completion

Remarks

Spudding Date

Drlg. Data Big Creek Pool

Location

J. E. TYRA

FORM 275 FOR SALE BY KANSAS BLUE PRINT CO.


County Russell State Kansas

Sec. 30 (Blk. Twp.) 14 (Sur. Rge.) 14W Map No.

Operator Cities Service

Well No. 6 Farm Ehrlich

Elev. 1822 Location NW SE NW

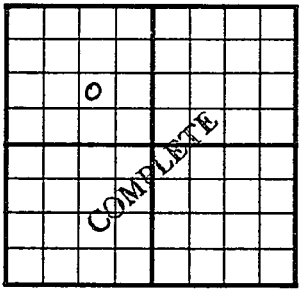

990 Ft. From S Line NW

990 Ft. From E Line Quarter

1st. Report

Completion OCT 4 1950

Remarks Big Creek Pool

Spudding Date 9-2-50

Drlg. Data Oil well TD 3246

8" @ 600 Heeb. 2943 Lans. 3006

Arb. 3244-46 5" @ 3245 TD 3246

FU 300' oil 1 hr. 930' oil 15 hr.

P/ 15 bo 12 hr. 500 A P/ 137 bo

Comp. 137 bo 127 bwpd

J. E. TYRA