


Section 30 Township 14 Range 14W
 Well No. #3 ~~#1-A~~ Brandenburg
 Company Francis Raymond

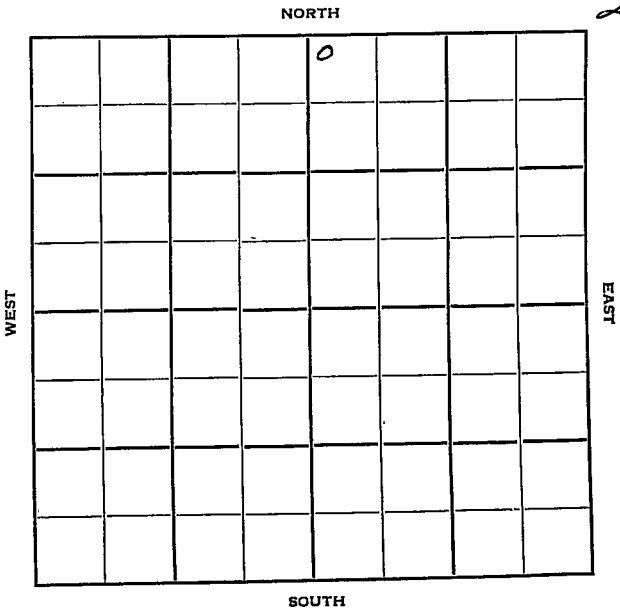

Russell

KANSAS

Sec. 30 Twp. 14 R. 14W

Well No. #1 A Brandenburg Farm

Francis Raymond

Company

Contractor

Big Creek Pool


165' Ft. from N. Line

Ft. from S. Line

Ft. from E. Line

165' Ft. from W. Line

NW NW NE

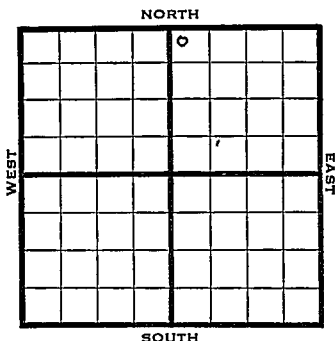

1950

Elev. 1823

REPORT

2/8

Spud 2-4-50
Anhy 860'
10-3/4" @ 864'
WOC

3/22

Anhy 860'
10 3/4" @ 864'
Topeka 2695'
Heebner 2928'
Lans 2986'
Arb. 3226'
7" @ 3227'
TD 3228'
DD 3235' TD
Fill up 200' fluid 15 hrs.
50% wtr.
Comp 35 BOPD
Comp

COMPLETED

Kansas

Big Creek Pool

Map No. _____ Sec. 30 Twp. 14 R. 14^W

Well No. 1-A Brandenburg

Francis Raymond _____ Company

Contractor

NW NW NE

El. 1823

SECTION PLAT

165 Ft. from N. Line

_____ Ft. from S. Line

_____ Ft. from E. Line

165 Ft. from W. Line



Russell County

Location _____

Rig up _____

Drilling and Remarks:

Spud 2-4-50

Anhy. 860

10 3/4" @ 864

WOC

RECORD

Cased _____ in., _____ ft.

Sand _____

Gas _____

Oil _____

Total Depth _____

PRODUCTION

1st 24 hrs. Nat. _____

1st 24 hrs. after shot _____

Gas _____ Cu. Ft.

Dry Hole _____

Abandoned _____

Date

FEB 8 1950

19

J. E. TYRA Scout

422828

Big Creek Pool

Map No. _____ Sec. 30 Twp. 14 R. 14WWell No. 3 Brandenburg

Francis Raymond _____ Company

CORRECTION _____ Contractor

NW NW NE

SECTION PLAT165 Ft. from N. Line

_____ Ft. from S. Line

_____ Ft. from E. Line

165 Ft. from W. Line

		0	

Russell County

Location _____

Rig up _____

Drilling and Remarks: _____

Reported

#1-A Brandenburg

RECORD

Cased _____ in., _____ ft.

Sand _____

Gas _____

Oil _____

Total Depth _____

PRODUCTION

1st 24 hrs. Nat. _____

1st 24 hrs. after shot _____

Gas _____ Cu. Ft.

Dry Hole _____

Abandoned _____

Date

FEB 15 1950 19 J. E. TYRA Scout

Map No. _____ Sec. 30 Twp. 14 R. 14WWell No. 3 Brandenburg_____
Francis Raymond _____ Company_____
Contractor

NW NW NE


E1. 1823

SECTION PLAT

165 Ft. from N. Line

_____ Ft. from S. Line

_____ Ft. from E. Line

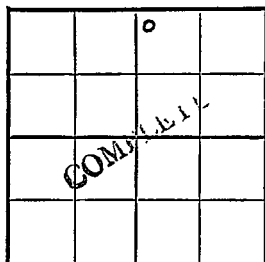165 Ft. from W. Line

Russell County

Location _____

Rig up _____

Drilling and Remarks:

anhy 860

10 3/4" 864

20 pcks 2695

Heelmer 2928

Lans. 2986

arb. 3226

7" C 3227

T.D. 3228

RECORD

Cased _____ in., _____ ft.

Sand _____

Gas _____

Oil _____

Total Depth _____

PRODUCTION

1st 24 hrs. Nat. _____

1st 24 hrs. after shot _____

Gas _____ Cu. Ft.

Dry Hole _____

Abandoned _____

Date

MAR 22 1950 19

J. E. TYRA

Scout

DD 3235 T.D.

Fill up 200' fluid 15 lbs. 50% water
Comp. 35 bph

MAR 30 1950

Misc.
Pierce Map
France Map
Tracings
Land-Wall Map
Land-Small Map
Scout Cards

TECH. 11/1/51