

# KANSAS

Russell

Section 30 Township 14 Range 14W

Well No. 4 Ehrlich "B"

Company Cities Service

Big Creek

NORTH

WEST

EAST

		0					

SOUTH

6

KANSAS

Russell



Sec. 30 Twp. 14 R. 14W

Well No. #4 Ehrlich "B" Farm

Cities Service Company

Big Creek Pool (Transit, Cont. NORTH)

\_\_\_\_\_ Ft. from N. Line

330'


\_\_\_\_\_ Ft. from S. Line

990'

\_\_\_\_\_ Ft. from E. Line

\_\_\_\_\_ Ft. from W. Line

SW SE NW

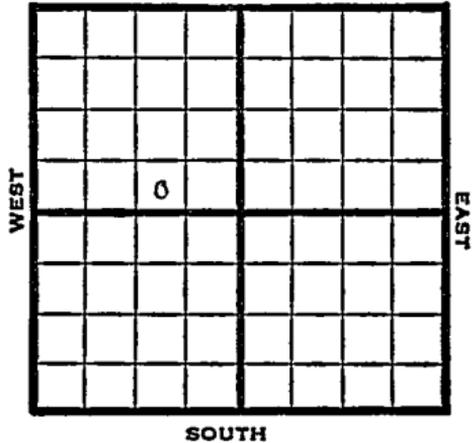

1949

Elev 1821' REPORT

- 6/1 RUR
- 6/7 8" @ 579'
- 6/15 Drlg. 3040'
- Lansing 3003'
- Arb. 3247'
- TD 3349'
- 5" @ 3348'
- 6/21 Pump 36 bbls oil in 6 hrs.
- 6/29 TD 3349'
- Arb. 3247'
- 5" @ 3348'
- Pump 126 Oil Pot
- 36° Gr.
- Comp

**COMPLETED**

Map No. \_\_\_\_\_ Sec. 30 Twp. 14 R. 14W

Well No. 4 Ehrlich "B"

Cities Service Company

Transit Contractor

SW SE NW

**FIRST REPORT  
SECTION PLAT**

\_\_\_\_\_ Ft. from N. Line

330 Ft. from S. Line

990 Ft. from E. Line

\_\_\_\_\_ Ft. from W. Line


Russell County

Location \_\_\_\_\_

Rig up \_\_\_\_\_

Drilling and Remarks:

R U R

**RECORD**

Cased \_\_\_\_\_ in., \_\_\_\_\_ ft.

Sand \_\_\_\_\_

Gas \_\_\_\_\_

Oil \_\_\_\_\_

Total Depth \_\_\_\_\_

**PRODUCTION**

1st 24 hrs. Nat. \_\_\_\_\_

1st 24 hrs. after shot \_\_\_\_\_

Gas \_\_\_\_\_ Cti. Ft.

Dry Hole \_\_\_\_\_

Abandoned \_\_\_\_\_

Date

JUN 1 1949

19

S. J. LEWIS

Scout

