

Russell

Map No. KANSAS Sec. 30 Twp. 14 R. 14W

Well No. 1- Reprint Farm _____
Darby Pit Company _____

_____ Ft. from N. Line

330


Ft. from S. Line

990

Ft. from E. Line

_____ Ft. from W. Line

Elevation 1758.

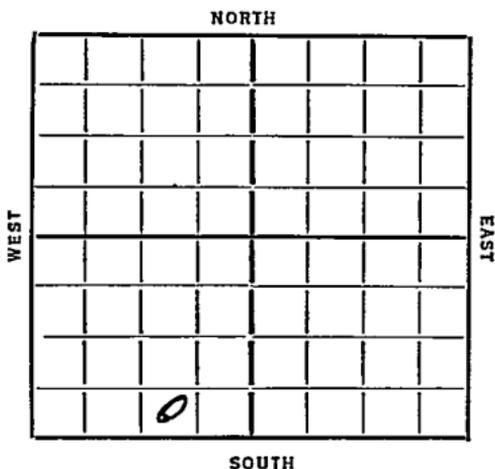

REPORT

Date	Description	Depth	Notes
12/18	Location		
12/26	PK		
12/36			
1/10	Spud		
1/17	2" 513 WOC		
1/24	Top Darby	755	10" 760
	elly	1415	
1/31	"	2275	
2/7	"	2828	8" 2450
2/14	Row	2944	6" 2945
	Run the Oil	2955-70	
	1/2 Boiler Oil P/H	2980-3000	
	TD	3100	WR 6"
2/21	Conq	3164	the Oil 3166-68 TD
			WR 6"
2/28	Oil	3168	HFV 3212-15 TD SD
3/4	Oil	3168	
	TD	3215	

D.O.A.

ABANDONED

Map No. 72 Sec. 30 Twp. 14 R. 14W

Well No. 1 - Reprint

Harby Pet. Company

Contractor

FIRST REPORTS

..... Ft. from N. Line

330 Ft. from S. Line

990 Ft. from E. Line

..... Ft. from W. Line

SECTION PLAT

Location

Rig up

Drilling and Remarks:

RECORD

Cased..... in., ft.

Sand.....

Gas.....

Oil.....

Total Depth.....

PRODUCTION

1st 24 hrs. Nat.....

1st 24 hrs. after shot.....

Gas..... Cu. Ft.

Dry Hole.....

Abandoned.....

Date

12-18-35 192.....

ORVAL MANNSCHRECK

Scout

