


Russell

SECTION 30 TOWNSHIP 14S RANGE 14W

WELL NO. #2 Rexroat "B"

COMPANY Okmar Oil

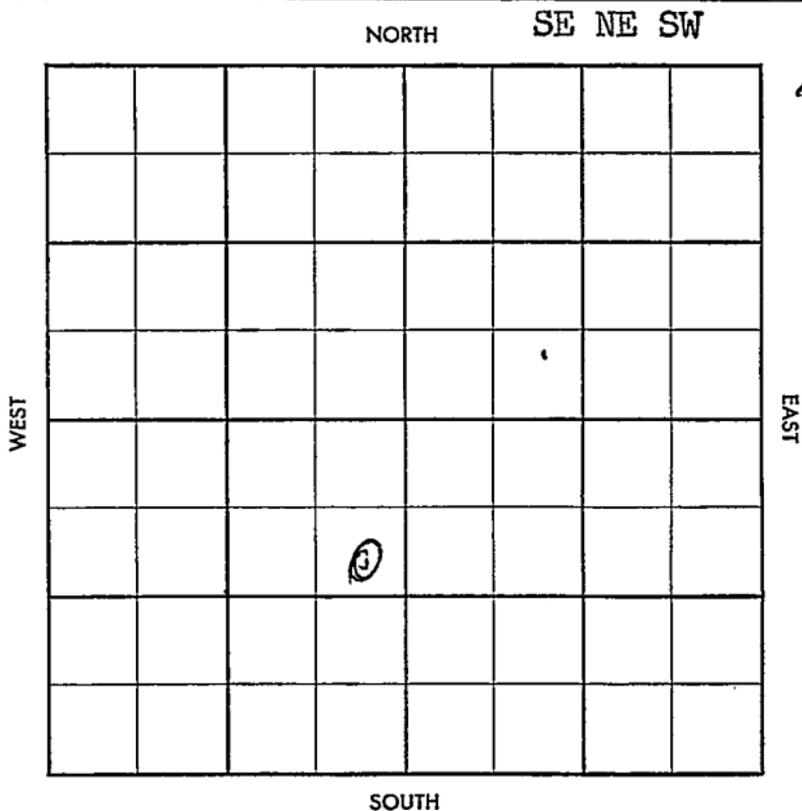

~~13~~

FORM 513 SUNRAY

County Russell Elev. _____

Sec. 30 Twp. 14 Rge. 1 W

Company Okmar Oil

Farm Name Herroat "B" No. 2

Co.

Lse.

No.

Sec.

T.

R.

TOPS	DEPTH	LOG	DATUM
Anh.			
Tp.			
H.			
Tr.			
Dg.			
Bl.			
L.			
K.C.			
B.K.C.			
Ce.			
C.			
M.			
M.			
K.			
Mz.			
Mq.			
V.			
S.			
S.			
A.			
R.			
PC.			
G.			
TD.			

Loc. in Sec. _____

SE NE SW

Geol. _____

Contr. _____

Leben Drlg.

Pool _____

Gorham

FIRST REPORT

SEP 13 '51

Date Comm. _____

Location _____

County Russell Elev. 1866 DF
 Sec. 30 Twp. 14 Rge. 14W
 Company Okmar Oil
 Farm Name Rexroat "B" No. 2

TOPS	DEPTH	LOG	DATUM	Loc. in Sec.
Anb.	817			SE 1/4 SW
TP.	2706			
H.	2930			
Tr.				
Dg.				Geol.
Bl.				
L.	2989			Contr.
K.C.				
B.K.C.				Leben Drlg.
Ce.				
C.				Pool
M.				
M.				Gorham
K.				
Mz.				<div style="border: 1px dashed black; padding: 5px; text-align: center;"> <p>COMPLETE</p> <p>NOV 6 '57</p> <p>0</p> </div>
Ma.				
V.				
S.				
S.				
A.				
R.				
Pe.				
G.				
TD.	3237			

Date Comm.

Location 79 23-57 82 825/400
WOC DST 2936-70 1hr
50' MW BHP 600/20" DS/ 2992
- 3022-1hr 250' GIP 50' oil/50'
OBGCM BHP 130/30" D at head
001 9 57 DST 3022-32 60" 6' M
BHP 0 DST 3162-90 60" 100 GIP
275' O B GCM BHP 680/20" no log
5L 3236/200 WOC DST 1957

DD 3257 AIS P/B
20/3172-77 (2) \$280PH NW
6 hrs

2530 pd NW

Lsg 3172-77

30-14-14w

se ne sw