

KANSAS


Form 51-5M-11-38-Palace

Russell

Section 30 Township 14 Range 14-W

Well No. #1 Rusch

Company Aylward Production

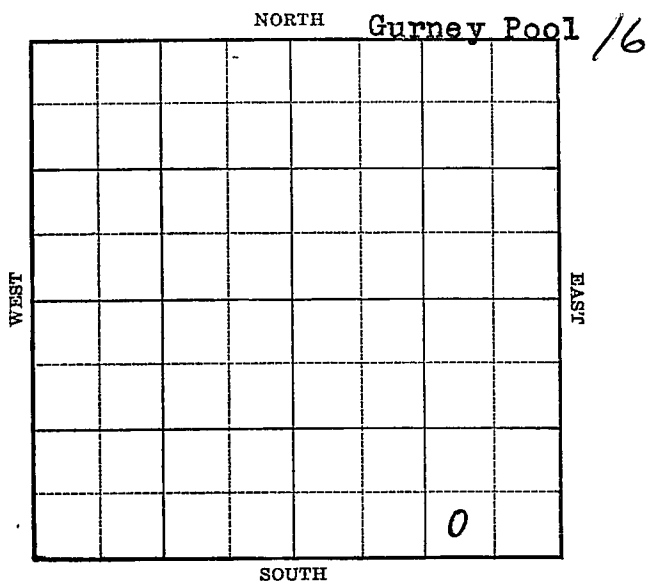

KANSAS

Russell

Sec. 30 Twp. 14 R. 14-W

Well No. #1 Rusch Farm

Aylward Prod. Company


(Gurney)

Ft. from N. Line

330 Ft. from S. Line

990 Ft. from E. Line

Ft. from W. Line

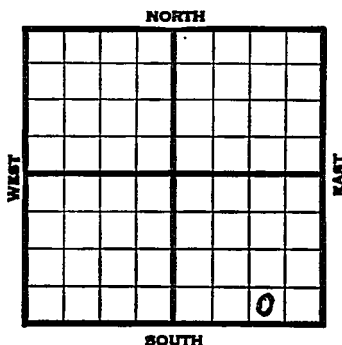

Elev. 1770

1939	REPORT
11/28	Cable location
12/7	Cable rig.
12/14	" "
12/21	" "
12/28	" "
1940	
1/4	" "
1/11	13" - 295'
	Drlg. 300'
1/18	13" - 327' Anhy 775'
	10" - 780' C.O.
1/25	Drlg. 1920'
2/1	Drlg. 2310'
2/8	SS gas 2345-50' 8" - 2358'
	Drlg. 2400'
2/15	8" - 2407' Lans. 2936' Drlg.
2/23	Lans. 2936' (Corrected)
	7" - 2936' T.D. 2963'
	Swab 10 bbls. per hour.
	OVER

1940

2/28

Lans. 2936'

7" - 2936'

T.D. 2983'

8000 acid.

Pump & flow 2961 bbls., potential

COMPLETED

Map No. 72 Sec. 30 Twp. 14 R. 14WWell No. 1 RuschAylward Production

Company

Contractor

FIRST REPORT

SW SE SE

 Ft. from N. Line330 Ft. from S. Line990 Ft. from E. Line Ft. from W. Line

GURNEY POOL

SECTION PLAT

Location XRig up

Drilling and Remarks:

Cable

RECORD

Cased in., ft.Sand Gas Oil Total Depth

PRODUCTION

1st 24 hrs. Nat. 1st 24 hrs. after shot Gas Cu. Ft.Dry Hole Abandoned

Date

NOV 28 1939 19S. J. LEWIS

Scout


Misc Small Maps.....
Cards.....
Tracing.....
France Map.....
Scarborough Map.....
Moody Map.....
Geological Dept.
Moody Flat Book

Map No. 72 Sec. 30 Twp. 14 R. 14WWell No. 1 RuschAylward Production Company

Contractor

COMPLETED

SW SE SE

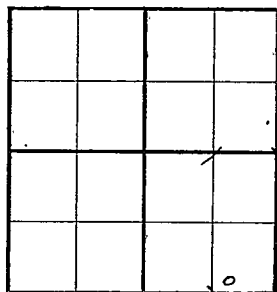SECTION PLAT Ft. from N. Line330 Ft. from S. Line990 Ft. from E. Line Ft. from W. Line**GURNEY POOL**Location Rig up

Drilling and Remarks:

*Lans 2986**7" @ 2936**8000 acid**Pump & Flow 2961**Post.***RECORD**Cased in., ft.Sand Gas Oil Total Depth 2983**PRODUCTION**1st 24 hrs. Nat. 1st 24 hrs. after shot Gas Cu. Ft.Dry Hole Abandoned

Date

FEB 2, 1944S. J. LEWIS Scout

Misc. Small Maps

Cards

Tracing

France Map

Scarborough Map

Moody Map

Geological Dept.

Moody Flat Book