

KANSAS

Form 51-5M-7-39-Palace


Russell

Section 30 ~~31~~ Township 14 Range 14-W

Well No. #1 Rusch (West)

Company Aylward et al

Allon Pool

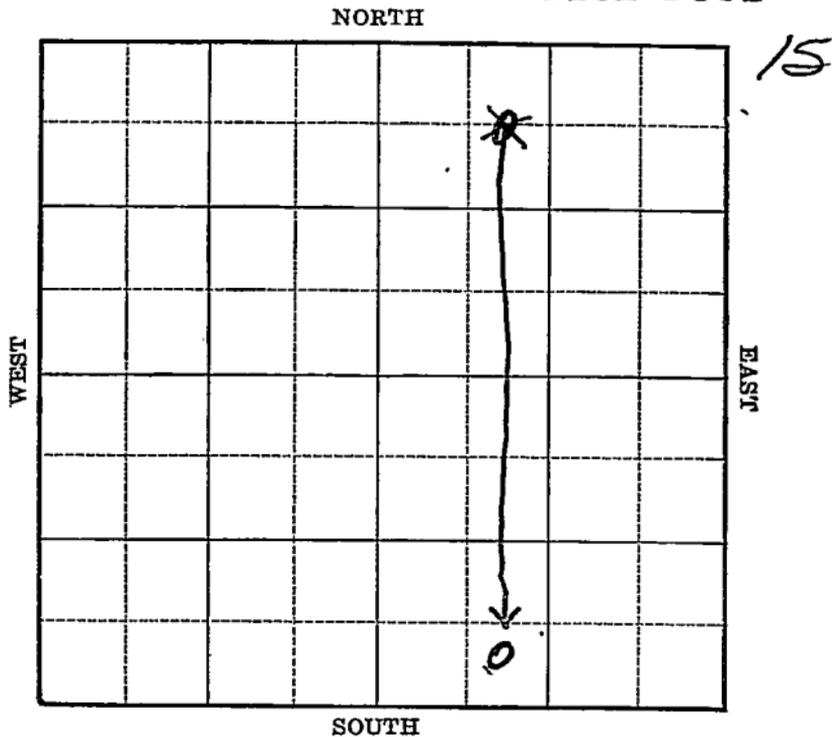

Sec. ~~30~~ 30 Twp. 14 R. 14-W

Well No. #1 Rusch (West) Farm

Aylward et al Company


(Allon)

~~660~~ Ft. from N. Line

400 Ft. from S. Line

Ft. from E. Line

990 Ft. from W. Line

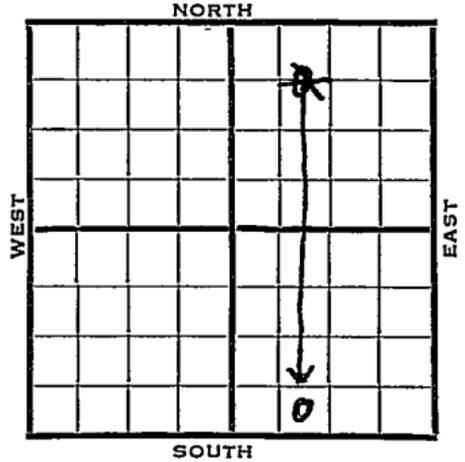

1940	REPORT
4/10	Bldg. cable rig.
4/18	" " "
4/25	Rigging up.
5/2	15" - 46' 12 1/2" - 443'
	Anhy 807' 10" - 810'
	Drlg. 1325'
5/9	Drlg. 1942'
5/16	SD 2200'
5/23	" "
5/29	8" - 2310' Drlg. 2375'
6/6	8" - 2460' S.O. 2600'
	Drlg. 2605'
6/13	6" - 2660' Drlg. 2715'
6/20	7" - 2932' Drlg. 2975'
6/27	Lans. 3003' 7" - 3131'
	Drlg. 3145'
7/3	Arb. 3215-55' T.D. 500' oil 2 hours. 1850' oil 1 bbl. water.

OVER

1940

7/10

Arb. 3215'

7" - 3131'

T.D. 3256'

Potential 788 bbls., pump.

COMPLETED

Map No. 72 Sec. 31 Twp. 14 R. 14W

Well No. 1 Rusch (West)

Aylward etal Company

Contractor

FIRST REPORT

C E L NW NE

660 Ft. from N. Line

_____ Ft. from S. Line

_____ Ft. from E. Line

990 Ft. from W. Line

ALLON POOL

SECTION PLAT

		0	

Location _____

Rig up _____

Drilling and Remarks:

Bldg. Cable Rig

RECORD

Cased _____ in., _____ ft.

Sand _____

Gas _____

Oil _____

Total Depth _____

PRODUCTION

1st 24 hrs. Nat. _____

1st 24 hrs. after shot _____

Gas _____ Cu. Ft.

Dry Hole _____

Abandoned _____

Date

APR 10 1940 19

S. J. LEWIS Scout

Misc. Small Map	<i>WMS</i>
Cards	<i>WMS</i>
Tracing	<i>WMS</i>
France Map	<i>WMS</i>
Scarborough Map	<i>WMS</i>
Moody Map	<i>WMS</i>
Geological Dept.	
Moody Flat Book	

KANSAS

Form 26-200 Bks. 1-40—Palace Russell

KANSAS

Map No. 72 Sec. 30 Twp. 14 R. 14W

Well No. 1 Rusch (West)

Aylward etal Company

CORRECTION Contractor

SECTION PLAT

SE SW SE

_____ Ft. from N. Line

400 Ft. from S. Line

_____ Ft. from E. Line

990 Ft. from W. Line

Location _____

Rig up _____

Drilling and Remarks:

Reported

C E L NW NE

31-14-14W

RECORD

Cased _____ in., _____ ft.

Sand _____

Gas _____

Oil _____

Total Depth _____

PRODUCTION

1st 24 hrs. Nat. _____

1st 24 hrs. after shot _____

Gas _____ Cu. Ft.

Dry Hole _____

Abandoned _____

Date

APR 23 1940 19

S. J. LEWIS Scout

Misc. Small Maps
Cards
Tracing
France Map
Scarborough Map
Moody Map
Geological Dept.
Moody Plat Book

Map No. _____ Sec. 30 Twp. 14 R. 14W

Well No. 1 Rusch (West)

_____ Aylward Etal. _____ Company

_____ Contractor

COMPLETED

SE SW SE

_____ Ft. from N. Line

400 Ft. from S. Line

_____ Ft. from E. Line

990 Ft. from W. Line

ALLON POOL

SECTION PLAT

Location _____

Rig up _____

Drilling and Remarks:

Co. 83215

7" (C313)

Pump 788 R.K.

RECORD

Cased _____ in., _____ ft.

Sand _____

Gas _____

Oil _____

Total Depth 3256

PRODUCTION

1st 24 hrs. Nat. _____

1st 24 hrs. after shot _____

Gas _____ Cu. Ft.

Dry Hole _____

Abandoned _____

Date

JUL 10 1940 19

S. J. LEWIS Scout

Misc. Small Maps	<i>BAW</i>
Cards	<i>BAW</i>
Tracing	<i>BAW</i>
France Map	<i>BAW</i>
Scarborough Map	<i>BAW</i>
Moody Map	<i>BAW</i>
Geological Dept.	
Moody Plat Book	