


Section 31 Township 14 Range 29W

Well No. #1 Lundgren

Company Wycoff & Williams

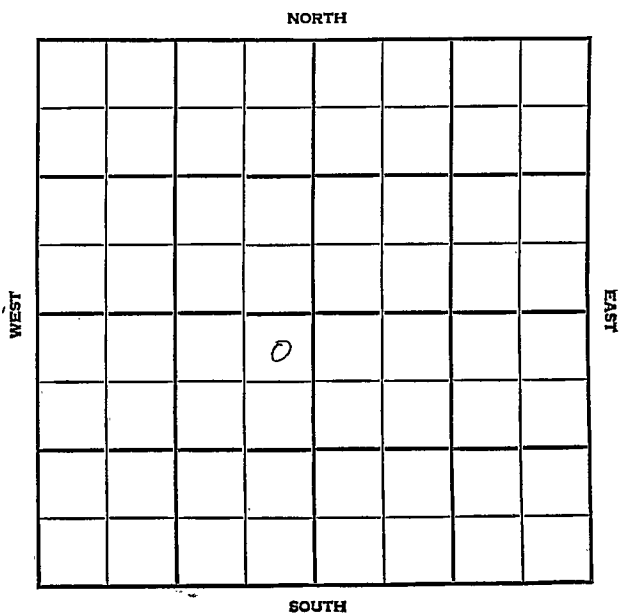


SEC. 31	TWP. - - 14	R. 29W
------------	----------------	-----------

WELL NO. #1 Lundgren FARM

COMPANY Wycoff & Williams

CONTRACTOR S. Lundgren

_____ FT. FROM N. LINE
 _____ FT. FROM S. LINE
 _____ FT. FROM E. LINE
 _____ FT. FROM W. LINE

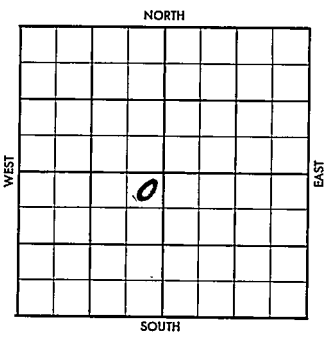

NE NE SW

1956	ELEVATION 2639'	REPORT
------	--------------------	--------

7-11 5" @ 4332
 Perf 4277-83, 2000 A
 Comp. in 1952 ror 236 bopd, dec to 17
 bopd;
 CO to 4326, 72/4314-23, 3000 A,
 S/ 120 bopd,
 P/ 100 bopd,
 Comp.
 H. 3639'; L. 3675'; BKG 3994';
 Marm. 4018'; Cherokee 4195'; Miss 4263'
 TD 4332'

FIRST REPORT
[Signature]
COMPLETED

County Greene Elev. 2639
 Sec. 37 Twp. 14 Rge. 29W
 Company Wycoff & Williams
 Farm Name Tandgren No. 1

TOPS	DEPTH	LOG	DATUM
Anh.			
Tr.			
H.	3639		
Tr.			
Dg.			
Bl.			
L.	3675		
K.C.			
B.K.C.	3994		
Ce.			
C. <u>Marm.</u>	4018		
M. <u>Cherokee</u>	4195		
M. <u>iss</u>	4263		
K.			
Mz.			
Me.			
V.			
S.			
S.			
A.			
R.			
Pe.			
G.			
TD.	4332		

Loc. in Sec. NE NE SW
 Geol. _____
 Contr. _____
 Pool _____
S. Tandgren

FIRST REPORT
 JUL 11 56
 COMPLETE

Date Comm. 5" @ 4332 perf/ 4277-83 2000 A
Comp. in 1952 for 236 bopd dec. to
17 bopd CO to 4326 72/ 4314-23
3000 A S/ 120 bopd P/ 100 bopd
 Comp. E.S. 1100

33

Co.
 Lse.
 No.
 Sec.
 T.
 R.