


Section 31 Township 14 Range 29W

Well No. 2 M. O'Connor

Company Wycoff Drlg.

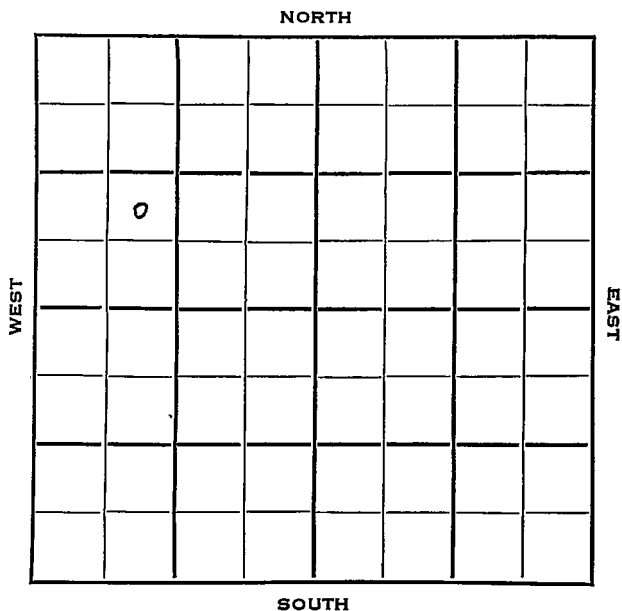

SEC.	TWP.	R.
31	14	29W

WELL NO. #2 M O'Connor FARM

COMPANY Wycoff Drlg.

CONTRACTOR Wycoff Drlg.

S. Lundgren Pool

NORTH

Ft. from N. Line


990

Ft. from S. Line

Ft. from E. Line

990

Ft. from W. Line

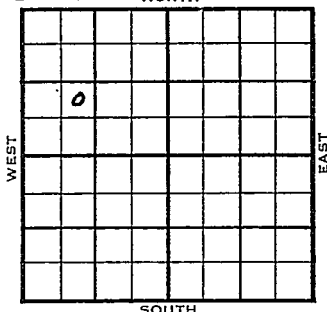

NE SW NW

	ELEVATION	REPORT
1953	2628'	
10/28	Spud 10-25-53 Set 8" WOC	
11/4	8" @ 99	
11/11	Drlg. 3422' NR	
11/18	Heeb 3633' Tor 3653' Lans 3667' B KC 3987' Marm 4015' Cher. 4161' Miss. 4260' RTD 4281' 5" @ 4280 Log.	
12/16	Spud 10-25-53 D & A TD 4281' 8" @ 99 Heeb 3633 Tor. 3653 Lans. 3667 B KC 3987 Marm 4015' Cherokee 4161 Miss. 4260 TD 4281 5" @ 4280 8/3934-38 S/3 BOPH 75% wtr. 8/3934-38 wtr. 500 A FU 1000' SW PB 3872 8/3854-62 5 GWPH PB 3830 8/3818- 26 FU 1000' wtr. PB 3815 8/3788-3802 FU 800' SW DD 4306 VSS 4000 A SP 4282 24/4269-73 16/4276-82 PB 3779 5/3744-45 dry. 9/3713-15 dry PB 3705 9/3691-93 9/3674-77 dry. PB 3670 9/3658-60 dry. D & A	

