


Gove

KANSAS

SECTION 31 TOWNSHIP 14S RANGE 29W

WELL NO. #3 Lundgren

COMPANY Wycoff Bros.

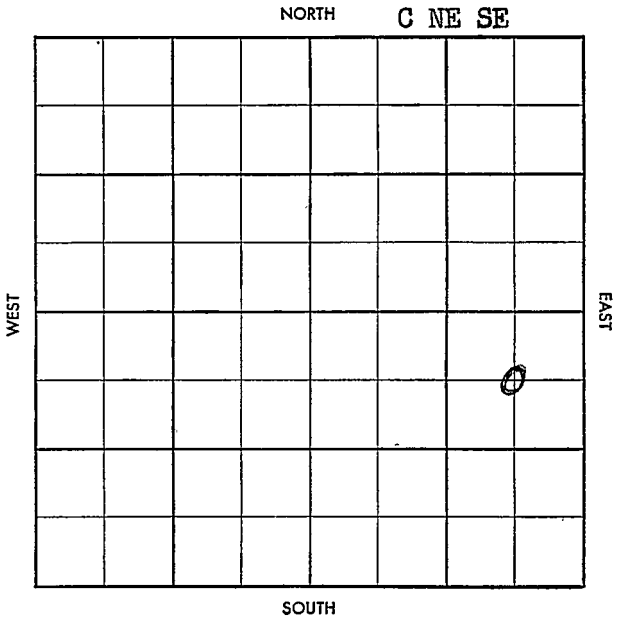

No. 110  
 No. 115  
 No. 116

S-513-B

County Cove Elev. 2613 DF 2616 KE  
 Sec. 31 Twp. 14S Rge. 29W  
 Company Wycoff Bros.  
 Farm Name Lindgren No. 3

TOPS	DEPTH	LOG	DATUM
Anh.	2010		
Tp.	3104		
H.	3634		
Tr.	3652		
Dg.			
B.L.			
L. <u>-K.C.</u>	3670		
K.C.			
B.K.C.			
Ce.			
C.			
M.			
M.			
K.			
Mz.			
Mq.			
V.			
S.			
S.			
A.			
R.			
Pf.			
G.			
T.D.			

Loc. in Sec. \_\_\_\_\_  
G NE SE  
 Geol. \_\_\_\_\_  
 Contr. Sierra Dr.  
#7  
 Pool \_\_\_\_\_  
Lindgren

Aug 13 1958  
**FIRST REPORT**

Date Comm. 8-4-58  
8" 150 w/115; D 3855

C  
 Sec.  
 T.  
 R.



5-573-B

County: Core State: 2613 DF 2616 KB  
 Sec: 34 Twp: 14S Rge: 29W  
 Company: Lycoff Bros.  
 Form Name: Lindgren No: 3

	TOPS	DEPTH	LOG	DATUM
Ann		2010		
TP		3101		
TD	3652	3611	3634	
TH		3632	3655	
Dp				
B.L				
L	-K.V.	3670	3671	
K.C				
B.K.C		3982	3986	
Ce	man	4004		
C	ce		4191	
M		4366	4270	
M.A				
K				
Mz				
Mg				
S				
S				
A				
R				
PT				
G				
TD		4356		

Loc. in Sec: G. N. E. S. E.  
 Geol: Sierra Drlg  
 Contr: #7

Pool: Lindgren  
 ABANDONED  
 SEE 10-18

Date Comm: 8-1-58  
BH 150 W/115; D 8855 AUG 20 58 DST  
3915-30 1hr 40' final 30'  
ann mo 60' 06 gcm 9 39'  
BHP 850 FP 920-5.30 DST  
4142-63 2hrs 220' top 100' 00  
200' SW FP 0-100 BHP 0-740  
DST 4269-96 1hr 60' M FP 0-0  
BHP 1210-900 DST 4226-4334  
1hr 10' 00 100' 0' 16W CM 150'

NY

MW FP 80-180 BHP 150-950

4 1/2 9.35 + 1200 AUG 27 '58 SEP 3 '58

SEP 10 '58 10.4320 120/4272-4302

PM USSO 1/4308 199W +

Light sound NT PB 9306

\$269W ph 550 4hrs PB

3963 14/3922 1/2 - 3926 550

ambw A 1BF ph 66 90W 10hrs

DOA

31-14-29

no se