

Section 31 Township 14 Range 29W

Well No. #1 Landgren

Company Wycoff-Williams

NORTH

			G				

WEST

EAST

SOUTH

Sec. **31** Twp. **14** R. **29W**

Well No. **#1 Lundgren** Farm

**Wycoff-Williams** Company


**Wildcat** Contractor

**330** Ft. from N. Line

Ft. from S. Line

**330** Ft. from E. Line

Ft. from W. Line

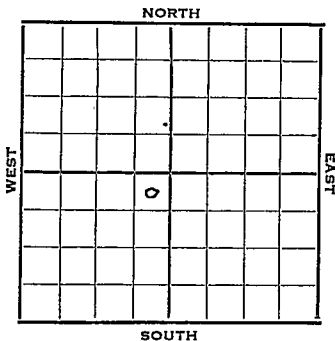

NE NE SW

Sinc. & Ohio DHM

1952 Elev. 2639' REPORT

7/30 MIM  
8/6 8" @ 128'  
Drlg. 3416'

8/13 Heeb. 3634' Dodge 3652  
Lans. 3673 B KC 4005  
DST 4203-21, 3/4 hrs. 30' HOCM  
10# f 4277-92, 2 1/2 hrs.  
Miss 4269  
DST 4274-4306 1 1/2 hr. 390' gas 120'  
clean oil 55' HOCM 1120#

8/20 TD 4332' 5" @ 4331' MICT  
Schl tops: Heeb 3639' Lans. 3675'  
BKC 3994' Marm 4018' Cherokee 4195'  
Miss 4263'  
(Back Dope) DST 4307-42, 2 hrs, 60'  
gas, 25' free oil, 855' SOCM 990#

8/27 CO 4300 24/4277-83 S/2 BOPH  
for 8 hrs. 50' A S/10 BOPH for 8 hrs.  
S/6 BOPH for 8 hrs. 2000 A CO  
S/12 BOPH for 2 hrs.

9/3 NR  
9/10 "  
9/17 Spud 7-28-52  
Oil Well TD 4332' 8" @ 128  
Heeb. 3634 Dodge 3652  
Lans. 3673 B, KC 4005  
DST 4203-21 open 3/4 hr. rec. 30'  
HOCM 10# Miss. 4269'

OVER

1952

9/17 DST 4274-4306 open 1½ hr. rec.  
390' gas 120' clean oil 55' hoem  
1120# TD 4332 5" @ 4331 - -  
Sch tops: Heeb. 3639 Lans. 3675  
B KC 3994 Marm 4018  
Cherokee 4195 Miss. 4263  
DST 4307-42 open 2 hr. rec. 60' gas  
25' free oil 855' socm 990#  
CO to 4300 24/ 4277-83 S/ 2 boph  
8 hr. 500 A S/ 10 boph S/ 6 boph  
2000 A S/ 13 boph  
Comp. 236 bopd

**COMPLETED**

County \_\_\_\_\_ Gove State Kansas

Sec. 31 (Blk. Twp.) 14 (Sur. Rge.) 29W Map No. \_\_\_\_\_

Operator Wycoff - Williams

Well No. 1 Farm Lundgren

Elev. \_\_\_\_\_ Location NE NE SW


FIRST REPORT

330 Ft. From N Line SW

330 Ft. From E Line Quarter

Ist. Report JUL 30 1952

Completion \_\_\_\_\_

Remarks Sinc. & Ohio - IHM

Spudding Date \_\_\_\_\_

Drlg. Data Wildcat


M I M

J. G. McGEHEE

Scout Cards .....  
Land Small Map.....  
Land Wall Map.....  
Tracings .....  
France Map .....  
P. orce Man .....  
Misc.....

AUG 1 1952

County Gove State Kansas  
 Sec. 31 (Blk. 14) (Sur. 29W) Map No. 14  
 Operator Wycoff - Williams  
 Well No. 1 Farm Lundgren  
 Elev. 2639 Location NE NE SW

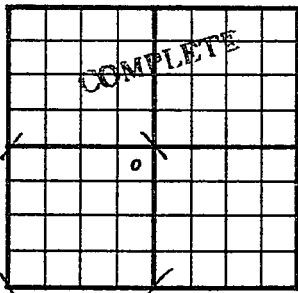

330 Ft. From N Line SW  
330 Ft. From E Line Quarter  
 1st. Report SEP 17 1952  
 Completion SEP 17 1952  
 Remarks Wildcat  
 Spudding Date 7-28-52

Drlg. Data Oil well TD 4332  
8" @ 128 Heeb. 3634 Dodge 3652  
Lans. 3673 B KC 4005. DST 4203-21  
open 3/4 hr. Rec. 30' hocm 10#  
Miss. 4269 DST 4274-4306 open 1 1/2 hr.  
Rec. 390' gas 120' clean oil 55' hocm  
1120# TD 4332 5" @ 4331

SCHLUMBERGER TOPS

Heeb. 3639 Lans. 3675 B KC 3994  
Marm. 4018 Cherokee 4195 Miss. 4263  
DST 4307-42 open 2 hr. Rec. 60' gas  
25' free oil 855' socm 990#  
CO to 4300 24/ 4277-83 S/ 2 boph 8 hr.  
500 A S/ 10 boph S/ 6 boph 2000 A  
S/ 13 boph Comp. 236 bopd

J. G. McGEHEE

Scout Cards

Land Small Map

Land Wall Map

Tracings

France Map

Pierce Map

Misc.

*W*

*BR*

SEP 24 1952

Orig. Date