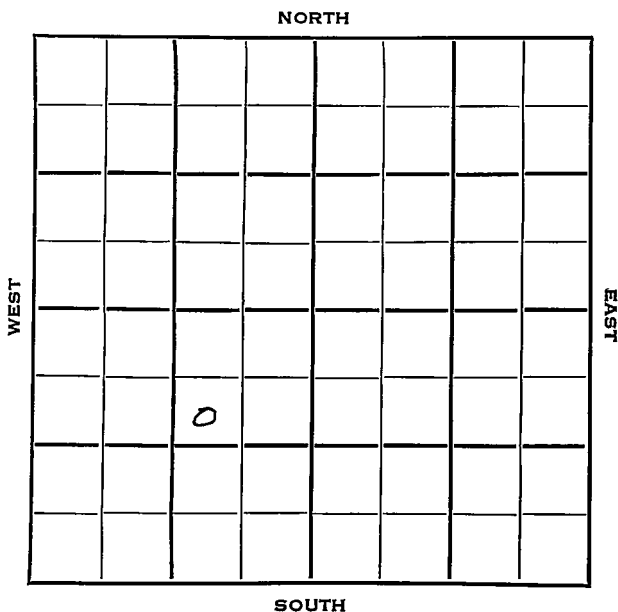


Section 31 Township 14 Range 29WWell No. #1 Lundgren #4 #2 LundgrenCompany Wycoff - Williams


Sec. 31 Twp. 14 R. 29 WWell No. #2 ~~#1~~ Lundgren ~~nan~~ FarmWycoff-Williams CompanyWycoff-Williams Contractor**S. Lundgren Pool**990 Ft. from N. Line

Ft. from S. Line

990 Ft. from E. Line

Ft. from W. Line

SW NE SW

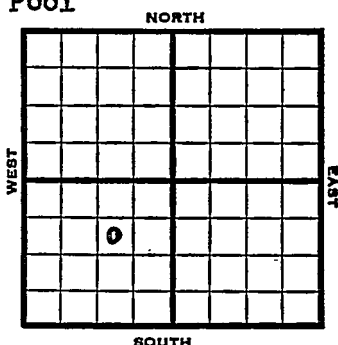

1953

Elev. 2663' REPORT

2/25

Spud 2-13-53
 8" @ 128 Heeb 3668'
 Drlg. 3800'

3/12

Heeb 3675' Tor 3696' Lans 3713'
 B KC 4030' Marm 4056' Miss 4306
 DST 4310-61 RTD 1½ hrs, 50' OCM
 1 GO free oil 4" @ 4350 GO 4346
 80/4329-3750 500 A SO
 3500 A S/25 BO plus 45 BWPD

3/19

16/4290-94 2000 A S/4 BO plus 12
 BW 3 hrs.

3/26

NR

4/1

Spud 2-13-53
 Oil Well
 TD 4351
 8" @ 128
 Heeb 3675, Tor 3696, Lans 3713, B KC
 4030, Marm 4056, Miss 4306,
 DST 4310-51 open 1½ hr. Rec 50' ocm
 1 gal. free oil 4" @ 4350
 CO to 4346
 80/ 4327-37 500A 3500 A
 S/ 25 bo 45 bwpd 16/4290-94 2000A
 S/4 no 12 bw 3 hr.
 Comp. 20 bopd 72% wtr.

COMPLETED

County **Gove** State **Kansas**

Sec. **31** (Blk. **14** (Sur. **29W** Map No.

Operator **Wycoff - Williams**

Well No. **1** Farm **Lundgren "A"**

Elev.	Location	SWNE SW
-------	----------	---------

FIRST REPORT

990: Ft. From N Line SW

990 Ft. From E Line Quarter

1st. Report FEB 25 1953

Completion

Remarks

Wycoff - Williams - Contr

Spudding Date 2-13-53

Drig. Data S. Lundgren Pool

8" @ 128 Heeb. 3668 drlg. 3800

Map No. _____ Sec. 31 Twp. 14 R. 29WWell No. 2 Lundgren

_____ Wycoff-Williams _____ Company

_____ CORRECTION _____ Contractor

SW NE SW

SECTION PLAT

990 Ft. from N. Line

_____ Ft. from S. Line

990 Ft. from E. Line

_____ Ft. from W. Line

Gove County

Location _____

Rig up _____

Drilling and Remarks:

Reported
#1 Lundgren "A"

RECORD

Cased _____ in., _____ ft.

Sand _____

Gas _____

Oil _____

Total Depth _____

PRODUCTION

1st 24 hrs. Nat. _____

1st 24 hrs. after shot _____

Gas _____ Cu. Ft.

Dry Hole _____

Abandoned _____

Date


MAR 4 1953

19

J. G. MCGHEE

Scout

County Gove State Kansas
 Sec. 31 (Blk. 14) (Sur. 29W) Map No. 29W
 Operator Wycoff - Williams
 Well No. 2 Farm Lundgren
 Elev. 2663 Location SW NE SW

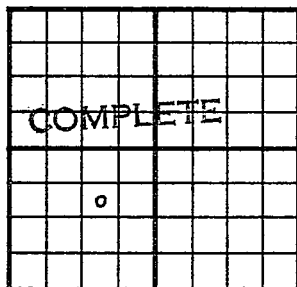

990 Ft. From N Line SW
990 Ft. From E Line Quarter

1st. Report

Completion APR 1 1953

Remarks S. Lundgren Pool
Wycoff-Williams - Contr.

Spudding Date 2-13-53

Drilg. Data Oil well TD 4351

8" @ 128 Heeb. 3675 Tor. 3696

Lans. 3713 B KC 4030. Marm. 4056

Miss. 4306 DST 4310-51 open $1\frac{1}{2}$ hr.

Rec. 50' ocm 1 gal. free oil 4" @ 4350

CO to 4346 80/ 4327-37 500 A 3500 A

S/ 25 bo 45 bwpd 16/ 4290-94 2000 A

S/ 4 bo 12 bw 3 hr.

Comp. 20 bopd 72% wtr.

J. G. McGEHEE