


Section 31 Township 14 Range 16 W

Well No. # 1 Wellbrook

Company D. G. Hansen

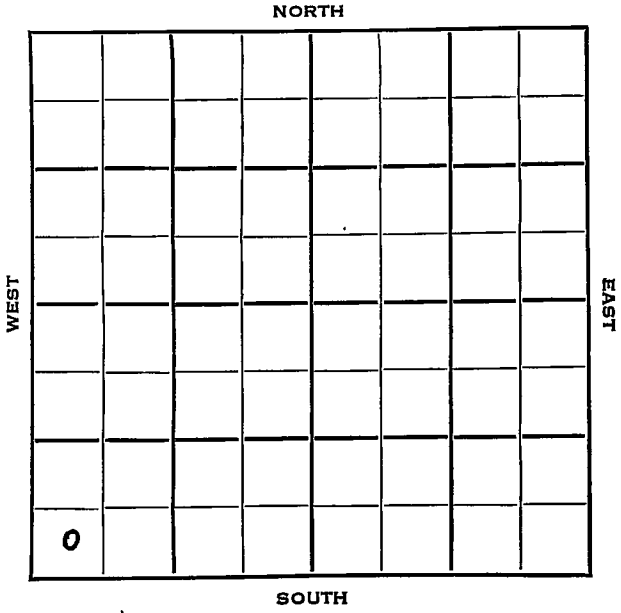

Ellis

KANSAS

SEC.	TWP.	R.
31	14	16W

WELL NO. 1 Wellbrock FARM

COMPANY D. G. Hansen

CONTRACTOR Cook & Galloway
Wildcat


_____ Ft. from N. Line

330 Ft. from S. Line

_____ Ft. from E. Line

330 Ft. from W. Line

SW SW SW

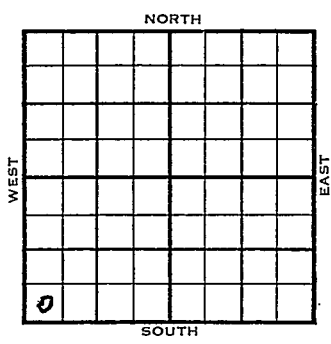

	ELEVATION	REPORT
1953	1930'	

9/9 MIR

9/16 Anhy 1058' 8" @ 1068
Drlg. 1850'

9/23 Spud 9-8-53
D&A
TD 3528'
Anhy 1058'
8" @ 1068'
Top 2939', Heeb 3167', Tor 3187',
Lans 3216', Cong 3460, Arb. 3478'
TD 3528'
D&A

ABANDONED

