

KANSAS

Russell

Section 31 Township 14 Range 14W

Well No. #2 Billings

Company Kingwood Oil

Big Creek

NORTH

					0		

10

WEST

EAST

SOUTH

**KANSAS**

Russell 14<sup>W</sup> ✓

Sec. 31 Twp. 14

Well No. #2 Billings Farm

Kingwood Oil Company

Big Creek Pool


330' Ft. from N. Line

\_\_\_\_\_ Ft. from S. Line

\_\_\_\_\_ Ft. from E. Line

990' Ft. from W. Line

NE NW SE

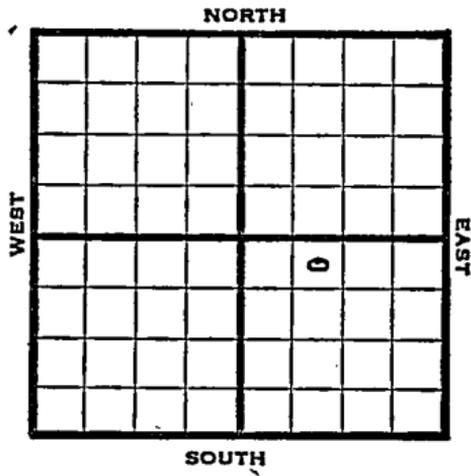

1948 Elev. 1728' REPORT

2/11 Surface hole  
Was an Aladdin lease

2/18 "

2/25 Lansing 2902'  
Drlg. 2939'

3/3 TD 3150'  
5" @ 3142'  
RUST

3/10 "

3/17 Lans. 2902'  
5" @ 3142'  
Pump 50 Pot.  
Gr. 390  
TD 3152'

**COMPLETED**

Map No. \_\_\_\_\_ Sec. 31 Twp. 14 R. 14W

Well No. 2 Billings

Kingwood Oil Company

FIRST REPORT Contractor

NE NW SE


SECTION PLAT

330 Ft. from N. Line

\_\_\_\_\_ Ft. from S. Line

\_\_\_\_\_ Ft. from E. Line

990 Ft. from W. Line

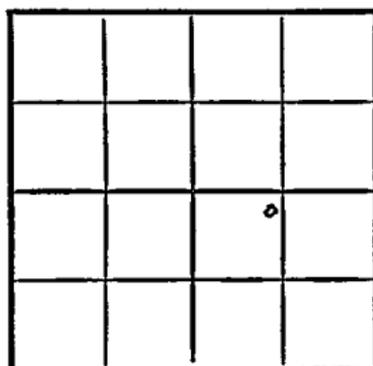

Russell County

Location \_\_\_\_\_

Rig up \_\_\_\_\_

Drilling and Remarks:

surface hole

Was an Aladdin

lease

RECORD

Cased \_\_\_\_\_ in., \_\_\_\_\_ ft.

Sand \_\_\_\_\_

Gas \_\_\_\_\_

Oil \_\_\_\_\_

Total Depth \_\_\_\_\_

PRODUCTION

1st 24 hrs. Nat. \_\_\_\_\_

1st 24 hrs. after shot \_\_\_\_\_

Gas \_\_\_\_\_ Cu. Ft.

Dry Hole \_\_\_\_\_

Abandoned \_\_\_\_\_

Date

FEB 11 1948

19

S. J. LEWIS

Scout

Map No. 72 Sec. 31 Twp. 14 R. 14W

Well No. 2 Billings

Kingwood Oil Company

**COMPLETE**

Contractor

NE NW SE

*E 11928*  
SECTION PLAT

330 Ft. from N. Line

\_\_\_\_\_ Ft. from S. Line

\_\_\_\_\_ Ft. from E. Line

990 Ft. from W. Line

		o	

Russell County

RECORD

Location \_\_\_\_\_

Cased \_\_\_\_\_ in., \_\_\_\_\_ ft.

Rig up \_\_\_\_\_

Sand \_\_\_\_\_

Drilling and Remarks:

Gas \_\_\_\_\_

*Line 2904*

Oil  \_\_\_\_\_

*5' 03142*

Total Depth 3152

*Pump 50 188*

PRODUCTION

1st 24 hrs. Nat. \_\_\_\_\_

1st 24 hrs. after shot \_\_\_\_\_

Gas \_\_\_\_\_ Cu. Ft.

Dry Hole \_\_\_\_\_

Abandoned \_\_\_\_\_

*39 2/3*

Date

MAR 17 1948

S. J. LEWIS Scout