


Russell

FORM 51 IOM 12-46 PETROL KANSAS

Section 31 Township 14 Range 14W

Well No. 1 Billings "B"

Company C. G. Kessinger

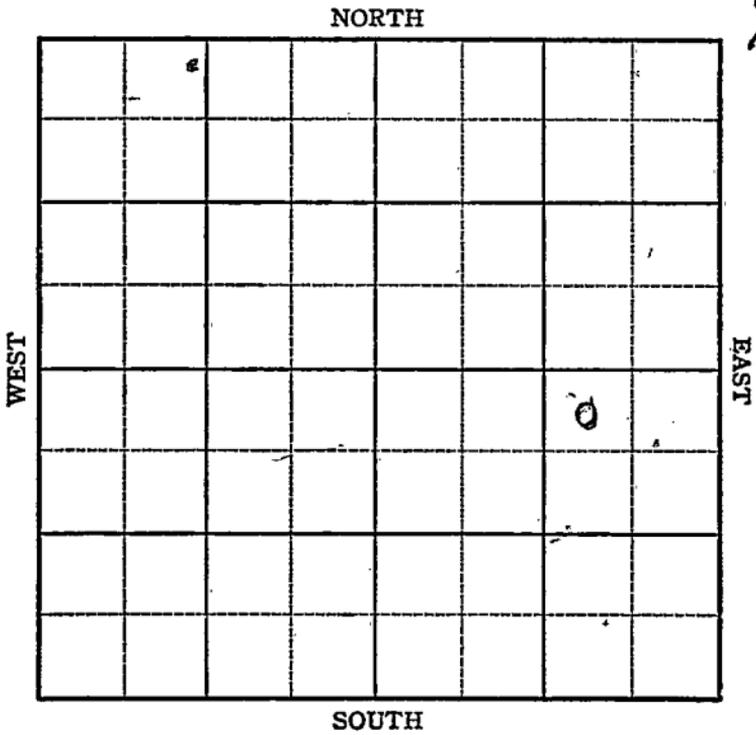

31

KANSAS

14

14W

Sec. _____ Twp. _____ R. _____

Well No. 1 Billings # B Farm _____

C. G. Kessinger Company _____

Hall-Gurney pool

330


Ft. from N. Line

Ft. from S. Line

990

Ft. from E. Line

Ft. from W. Line

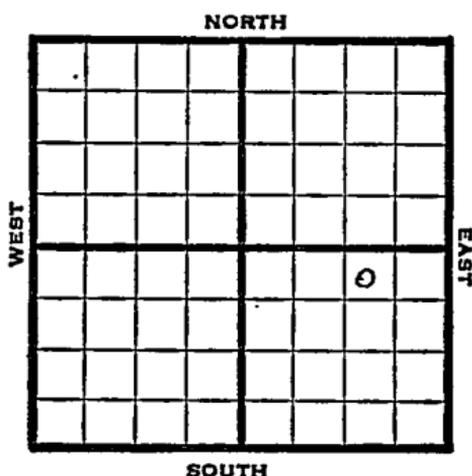

NW NE SE

1947 Elev. 1730' REPORT

5/28

Spud

6/3

15" @ 114

13" @ 368

Drlg 570'

6/10

Drlg. 820'

6/17

Drlg 1500'

6/24

Drlg 2310'

7/1

Drlg 2600'

7/8

Topeka 2615'

Lansing 2900'

Drlg 2985'

7-16

Arbuckle 3145'-46 TD

7" @ 3145 - 1000' oil 12 hrs.

7/23

Arbuckle 3145'

7" @ 3145'

Pump 25 Pot.

Gr. 40.9

T.D. 3146'

Complete

COMPLETED

Map No. _____ Sec. 31 Twp. 14 R. 14W

Well No. 1 Billings "B"

C. G. Kessinger Company

FIRST REPORT Contractor

NW NE SE

SECTION PLAT

330 Ft. from N. Line

_____ Ft. from S. Line

990 Ft. from E. Line

_____ Ft. from W. Line

			o

Russell County

Location _____

Rig up _____

Drilling and Remarks:

Spud

RECORD

Cased _____ in., _____ ft.

Sand _____

Gas _____

Oil _____

Total Depth _____

PRODUCTION

1st 24 hrs. Nat. _____

1st 24 hrs. after shot _____

Gas _____ Cu. Ft.

Dry Hole _____

Abandoned _____

Date

MAY 28 1947

S. J. LEWIS Scout

Map No. 72 Sec. 31 Twp. 14 R. 14W

Well No. 1 Billings "B"

C. G. Kessinger Company

COMPLETE

Contractor

NW NE SE

E11730
SECTION PLAT

330 Ft. from N. Line

_____ Ft. from S. Line

990 Ft. from E. Line

_____ Ft. from W. Line

			0

Russell County

Location _____

Rig up _____

Drilling and Remarks:

Cost \$2145-
7" @ \$2145-
Pump 2500

40 I/G

RECORD

Cased _____ in., _____ ft.

Sand _____

Gas _____

Oil _____

Total Depth 2146

PRODUCTION

1st 24 hrs. Nat. _____

1st 24 hrs. after shot _____

Gas _____ Cu. Ft.

Dry Hole _____

Abandoned _____

Date

JUL 23 1947 19

S. J. LEWIS Scout