


Section 31 Township 14 Range 14-W

Well No. #1 Dumler

Company C. G. Kessinger  
Hall-Gurney

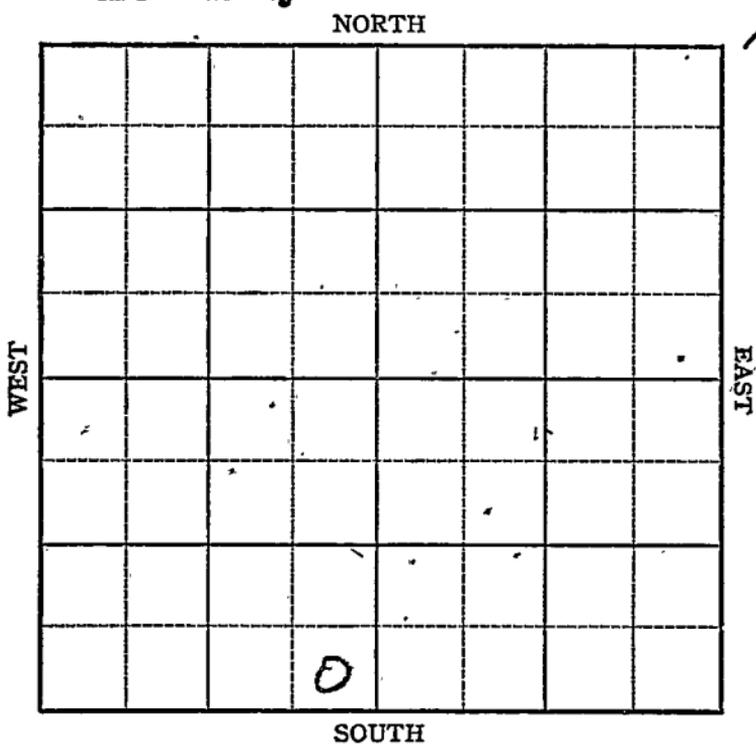


Sec. 31 Twp. 14 R. 14W

Well No. 1 Dumler Farm  
C. G. Kessinger Company

Hall-Gurney

NORTH

         Ft. from N. Line

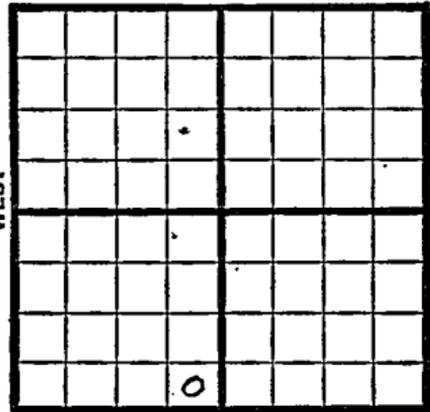

330 Ft. from S. Line

330 Ft. from E. Line

         Ft. from W. Line

SOUTH

SE SW

1947 Elev. 1737' REPORT

6/25	Location
7/1	Mach.
7/8	Drlg 100'
7-16	Drlg. 200
7/22	15" @ 47' Drlg 200'
7/29	SD
8/6	"
8/13	"
8/20	"
8/27	200' SD for crew
9/3	"
9/10	"
9/17	13" @ 440' Drlg. 446'

OVER

1947

- 9/24 10" @ 748'  
Drlg. 1010'
- 10/1 Drlg. 2005'
- 10/8 8" @ 2385'  
Topeka 2580'  
Drlg. 2600'
- 10/15 Dodge 2880'  
Drlg. 2895'
- 10/22 Lansing 2925'  
7" @ 2891'  
Drlg. 3125'
- 10/29 Arbuckle 3167'  
TD 3171'  
7" @ 3167'  
2500' oil 14 hrs.
- 11/5 Pipe collapsed
- 11/12 "
- 11/19 "
- 11/25 "
- 12/3 "
- 12/10 SD "
- 12/17 "
- 12/30 "
- 1948  
1/7 "
- 1/14 "
- 1/21 "
- 1/28 Arb. 3167'  
7" @ 3167'  
Pump 70 Pot  
40.0 Gr.  
TD 3173'  
Comp.

**COMPLETED**

Map No. \_\_\_\_\_ Sec. 31 Twp. 14 R. 14W

Well No. 1 Dumler

C. G. Kessinger Company

FIRST REPORT Contractor

SE SW


SECTION PLAT

\_\_\_\_\_ Ft. from N. Line

330 Ft. from S. Line

330 Ft. from E. Line

\_\_\_\_\_ Ft. from W. Line

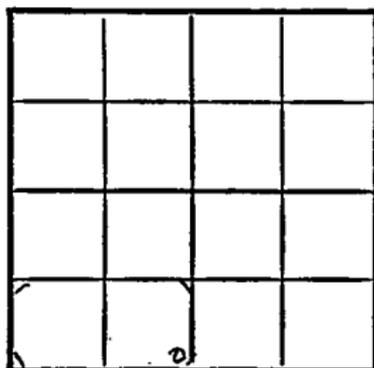

Russell County

Location \_\_\_\_\_

Rig up \_\_\_\_\_

Drilling and Remarks:

RECORD

Cased \_\_\_\_\_ in., \_\_\_\_\_ ft.

Sand \_\_\_\_\_

Gas \_\_\_\_\_

Oil \_\_\_\_\_

Total Depth \_\_\_\_\_

PRODUCTION

1st 24 hrs. Nat. \_\_\_\_\_

1st 24 hrs. after shot \_\_\_\_\_

Gas \_\_\_\_\_ Cu. Ft.


Dry Hole \_\_\_\_\_

Abandoned \_\_\_\_\_

Date

JUN 25 1947 19

S. J. LEWIS Scout

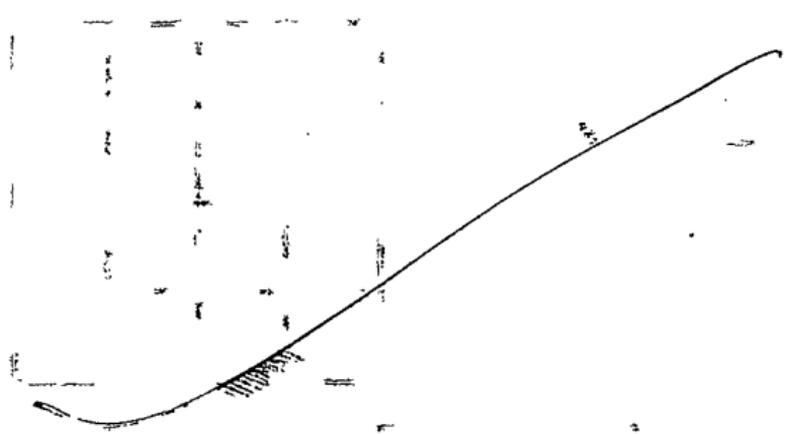

- Misc. Small Maps
- Cards
- Tracing
- France Map
- Scarborough Map
- Pierce Map
- Geological Dept.
- Pierce Plat Book

Map No. 72 Sec. 31 Twp. 14 R. 14W

Well No. 1 Dumlér

C. G. Kessinger Company

**COMPLETE** Contractor

SE SW

*E 11297*  
SECTION PLAT


\_\_\_\_\_ Ft. from N. Line

330 Ft. from S. Line

330 Ft. from E. Line

\_\_\_\_\_ Ft. from W. Line

Russell County

Location \_\_\_\_\_

Rig up \_\_\_\_\_

Drilling and Remarks:

*Cr + 3167*

*7" @ 3167*

*Pump 70 Rod*

*40' Lu*

**RECORD**

Cased \_\_\_\_\_ in., \_\_\_\_\_ ft.

Sand \_\_\_\_\_

Gas \_\_\_\_\_

Oil  \_\_\_\_\_

Total Depth 3173

**PRODUCTION**

1st 24 hrs. Nat. \_\_\_\_\_

1st 24 hrs. after shot \_\_\_\_\_

Gas \_\_\_\_\_ Cu. Ft.

Dry Hole \_\_\_\_\_

Abandoned \_\_\_\_\_

Date

JAN 28 1948

19

**S. J. LEWIS**

Scout

to

misc. Small Maps	<i>CK</i>
Cards	<i>CK</i>
Tracing	<i>CK</i>
France Map	<input checked="" type="checkbox"/>
Scarborough Map	
Pierce Map	<i>CK</i>
Geological Dept.	
Pierce Plat Book	