
KANSAS
FORM 51 5M PETROL

Russell

Section 31 Township 14 Range 14W

Well No. #1 Dumler

Company McGuire Industries

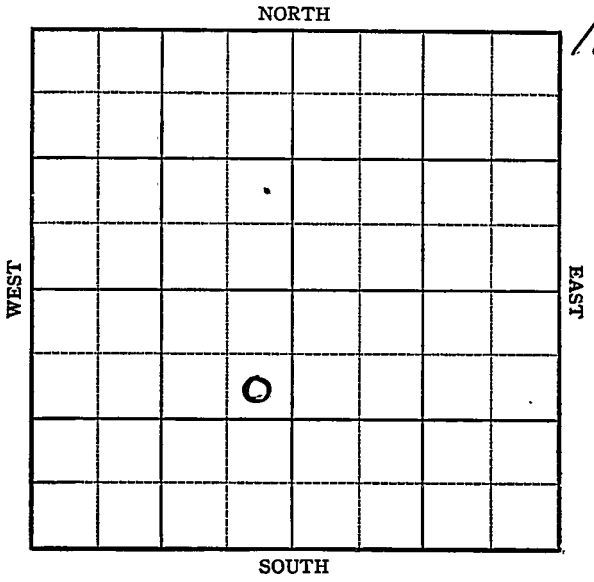

11.

FORM 252-S
5M 3-44 PETROL

KANSAS

Russell

Sec. 31 Twp. 14 R. 14W

Well No. #1 Dumler Farm

McGuire Industries Company

was Auto Ordnance


Hall-Gurney

990 Ft. from N. Line

Ft. from S. Line

330 Ft. from E. Line

Ft. from W. Line

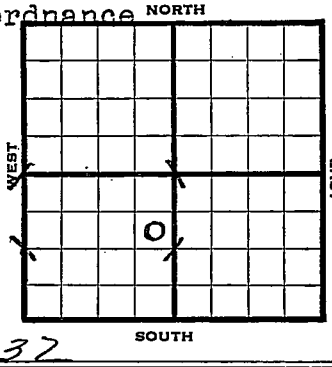

Elev. 1732

1944	REPORT
4/12	Location
4/19	"
4/26	"
5/3	"
5/10	Cable rig
5/17	Rigging up
5/24	15" @ 93' 160 fsg.
5/31	" "
6/7	" "
6/15	Skid rig 25' south
6/21	Rigging Up
6/28	15" @ 95' 13" @ 450 Drlg 525

OVER

1944

7/12 Anhy 735 Drlg 1610
7/19 Drlg 2265

7/26 8" @ 2375
Topeka 2638
Drlg. 2760'

8/2 Dodge 2886
Lans 2727
Drlg. 3080

8/9 Arb. 3165-67 TD SO
5" @ 3165 WOC

8/16 " " " " " "

8/23 Arb 3165
5" @ 3165
Pump 100 Pot
TD 3168
Garv. 39

COMPLETED

Form 26 200 Bks 5-42 Petrol Russell

KANSAS

Map No. 72 Sec. 31 Twp. 14 R. 14W


Well No. 1 Dumler

McGuire Industries
was Auto Ordnance Company

Contractor

SE NE SW FIRST REPORT

SECTION PLAT

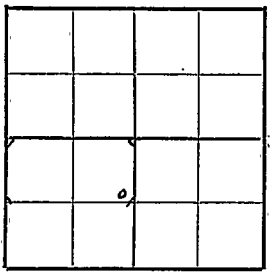

990 Ft. from N. Line

Ft. from S. Line

330 Ft. from E. Line

Ft. from W. Line

Hall-Gurney Pool

Location X

Rig up

Drilling and Remarks:

RECORD

Cased in., ft.

Sand

Gas

Oil

Total Depth

PRODUCTION

1st 24 hrs. Nat.

1st 24 hrs. after shot

Gas Cu. Ft.

Dry Hole

Abandoned

Date

APR 12 1944 19

S. J. LEWIS Scout

Misc. Small Maps
Cards
Tracing
France Map
Scarborough Map
Moody Map
Geological Dept
Moody Plat Book

FORM 26 200 BKS. 2-44 PETROL

Pool Name Hall-Gurney


Map No. 72 Sec. 31 Twp. 14 R. 14W

Well No. 1 Dumler

McGuire Industries Company

SE NE SW COMPLETED Contractor

SECTION PLAT

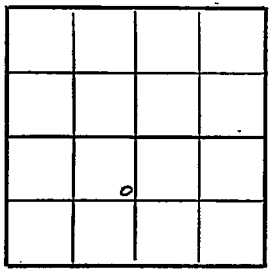

990 Ft. from N. Line

_____ Ft. from S. Line

330 Ft. from E. Line

_____ Ft. from W. Line

Russell County

Location

Rig up

Drilling and Remarks:

Csg @ 3165'.

5" @ 3165'.

Pump 100 Bbl

39° Gr

RECORD

Cased ____ in., ____ ft.

Sand

Gas

Oil

Total Depth 3165

PRODUCTION

1st 24 hrs. Nat.

1st 24 hrs. after shot

Gas ____ Cu. Ft.


Dry Hole

Abandoned

Date

AUG 23 1944 19

S. J. LEWIS Scout

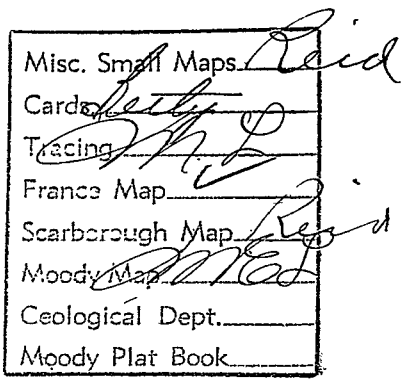
Misc. Small Maps
Cards
Tracing
France Map
Scarborough Map
Moody Map
Geological Dept.
Moody Plat Book