

Russell

FORM 5710M, 12-46 PETROL  
KANSAS

Section 31 Township 14 Range 14-W

Well No. 1 Rexrott

Company Alkay Oil


Hall-Gurney

NORTH

WEST

EAST

SOUTH

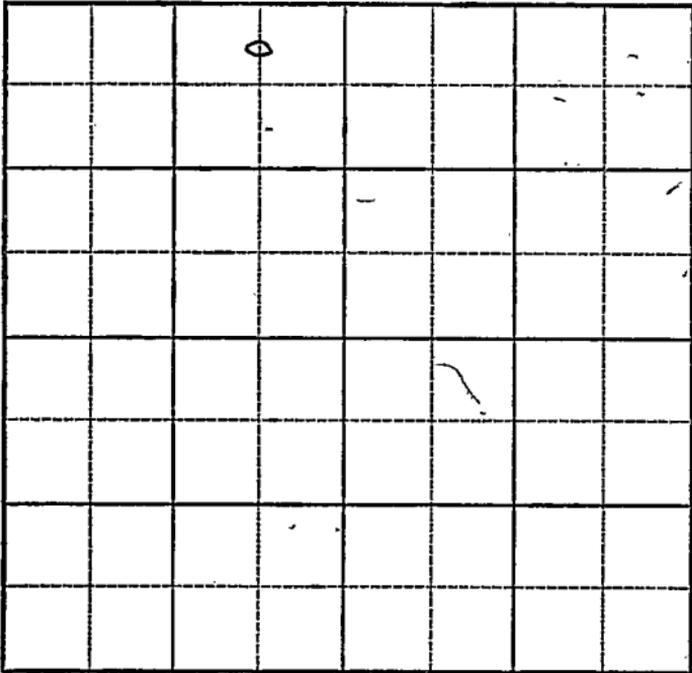

KANSAS

Russell



Sec. 31 Twp. 14 R. 14W

Well No. 1 Rexrott Farm

Alkay Oil Company

Hall-Gurney


330 Ft. from N. Line

\_\_\_\_\_ Ft. from S. Line

660 Ft. from E. Line

\_\_\_\_\_ Ft. from W. Line

D N L NE NW

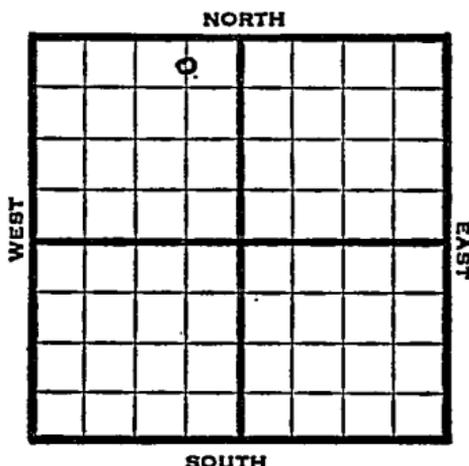

1947 Elev. 1735' REPORT

8/13	RUR
8/20	10" @ 390 Drlg. 2070'
8/27	7" @ 3162' RUST
9/3	Arbuckle 3152 7" @3153 TD 3162 Rust
9/10	"
9/17	"
9/24	Arb. 3152' 7" @ 3153' Pump 35 oil / 5% W pot 41.0 Gr. TD 3162'

**COMPLETED**

Map No. \_\_\_\_\_ Sec. 31 Twp. 14 R. 14W

Well No. 1 Rexrott

Alkay Oil Company

**FIRST REPORT**

Contractor

C N L NE NW


**SECTION PLAT**

330 Ft. from N. Line

\_\_\_\_\_ Ft. from S. Line

660 Ft. from E. Line

\_\_\_\_\_ Ft. from W. Line

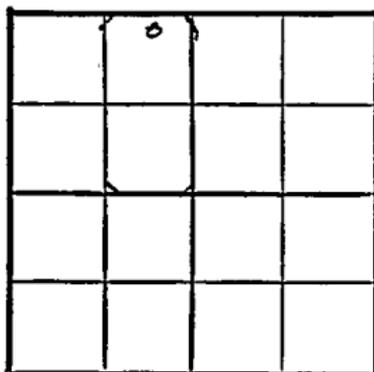

Russell County

Location \_\_\_\_\_

Rig up \_\_\_\_\_

Drilling and Remarks:

R U R

**RECORD**

Cased \_\_\_\_\_ in., \_\_\_\_\_ ft.

Sand \_\_\_\_\_

Gas \_\_\_\_\_

Oil \_\_\_\_\_

Total Depth \_\_\_\_\_

**PRODUCTION**

1st 24 hrs. Nat. \_\_\_\_\_

1st 24 hrs. after shot \_\_\_\_\_

Gas \_\_\_\_\_ Cu. Ft.

Dry Hole \_\_\_\_\_

Abandoned \_\_\_\_\_

Date

AUG 13 1947 19

S. J. LEWIS Scout

Map No. 77 Sec. 31 Twp. 14 R. 14W

Well No. 1 Rexrott

Alkay Oil Company

**COMPLETE**

Contractor

C N L N E N<sup>W</sup>

*E 1 1935*  
**SECTION PLAT**

330 Ft. from N. Line

	0		

\_\_\_\_\_ Ft. from S. Line

660 Ft. from E. Line

\_\_\_\_\_ Ft. from W. Line

Russell County

**RECORD**

Location \_\_\_\_\_

Cased \_\_\_\_\_ in., \_\_\_\_\_ ft.

Rig up \_\_\_\_\_

Sand \_\_\_\_\_

Drilling and Remarks:

Gas \_\_\_\_\_

Oil \_\_\_\_\_

Total Depth 2162

=====

**PRODUCTION**

1st 24 hrs. Nat. \_\_\_\_\_

1st 24 hrs. after shot \_\_\_\_\_

Gas \_\_\_\_\_ Cu. Ft.

Dry Hole \_\_\_\_\_

Abandoned \_\_\_\_\_

=====

*Per 83152  
7" C 2153  
Pump 25 oil 45% oil  
B.V.  
412/41*

Date

SEP 24 1947

19

S. J. LEWIS

Scout