


Section 31 Township 14 Range 14- W

Well No. 2 Billings "B"

Company C. G. Kessinger

Hall-Gurney Pool NORTH

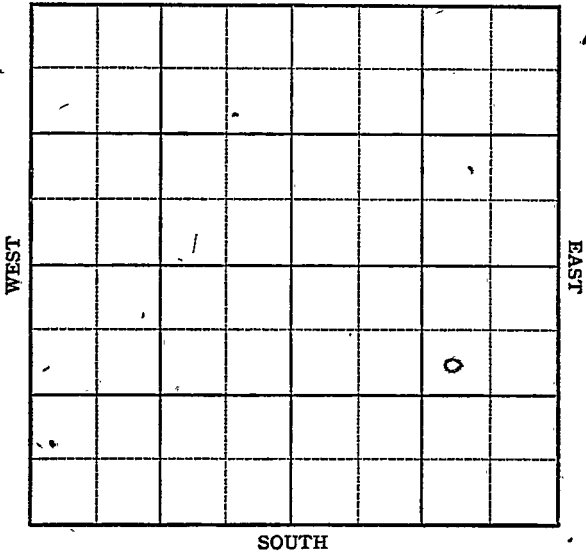

KANSAS. Russell County

Sec. 31 Twp. 14 R. 14W

Well No. 2 Billings "B" Farm

C. G. Kessinger Company

Hall-Gurney Pool


990 Ft. from N. Line

Ft. from S. Line

990 Ft. from E. Line

Ft. from W. Line

SW NE SE

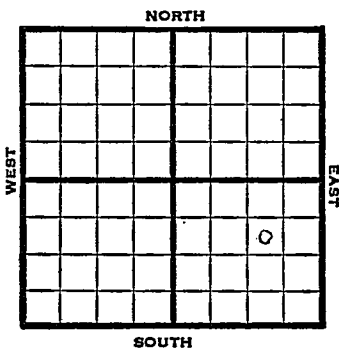

1947 Elev. 1378' REPORT

7-16	Log.
7/22	"
7/29	Rigging up
8/6	15" @ 140' Drlg 225'
8/13	10" @ 745' WOC
8/20	Drlg. 1535'
8/27	Drlg. 2285'
9/3	8" @ 2385 Drlg 2700
9/10	2740' fsg.
9/17	Lansing 2927' 7" @ 2960' Drlg. 2970'
9/24	"
10/1	Lans. 2927 7" @ 2960 Pump 200 Pot. TD 2970 Gravity 40

**COMPLETED**

Map No. \_\_\_\_\_ Sec. 31 Twp. 14 R. 14W

Well No. 2 Billings "B"

C. G. Kessinger Company

**FIRST REPORT** Contractor

SW NE SE

**SECTION PLAT**

990 Ft. from N. Line

\_\_\_\_\_ Ft. from S. Line

990 Ft. from E. Line

\_\_\_\_\_ Ft. from W. Line


Russell County

Location X

Rig up \_\_\_\_\_

Drilling and Remarks:

**RECORD**

Cased \_\_\_\_\_ in., \_\_\_\_\_ ft.

Sand \_\_\_\_\_

Gas \_\_\_\_\_

Oil \_\_\_\_\_

Total Depth \_\_\_\_\_

**PRODUCTION**

1st 24 hrs. Nat. \_\_\_\_\_

1st 24 hrs. after shot \_\_\_\_\_

Gas \_\_\_\_\_ Cu. Ft.

Dry Hole \_\_\_\_\_

Abandoned \_\_\_\_\_

Date

JUL 16 1947

19

S. J. LEWIS

Scout

