


Russell

Section 31 Township 14 Range 14W

Well No. 1 Solbach

Company Aylward Prod.

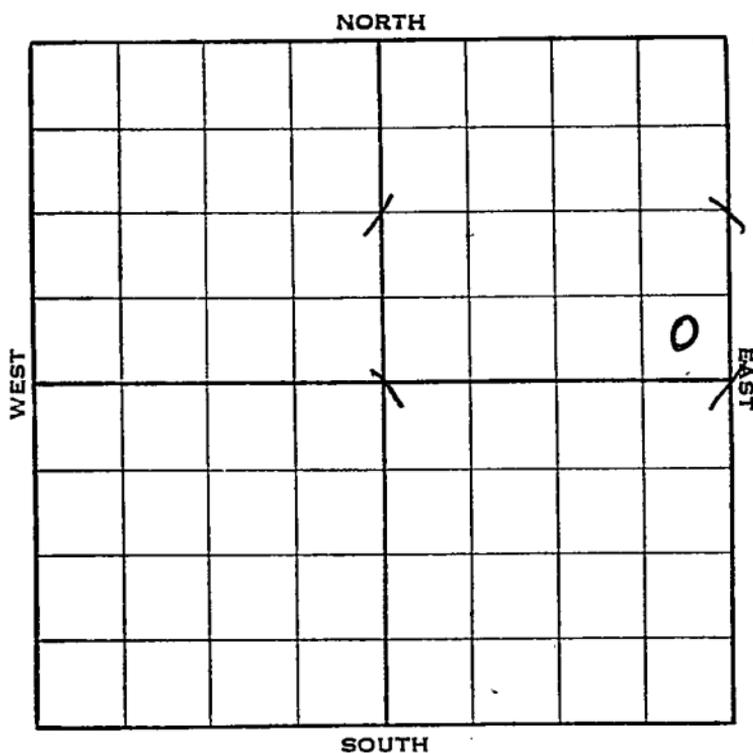

Sec. 31 Twp. 14 R. 14-W

Well No. #1 Solbach Farm


Aylward Prod. Company

_____ Ft. from N. Line

330 Ft. from S. Line

330 Ft. from E. Line

_____ Ft. from W. Line

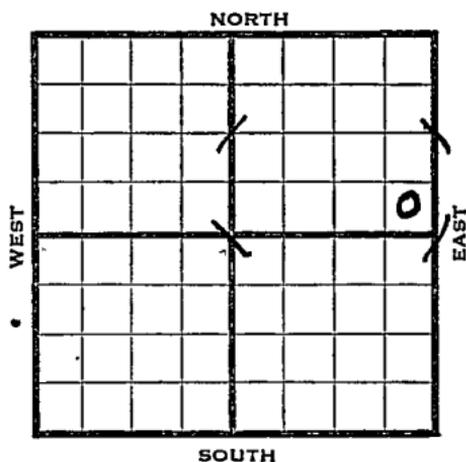

Elev. 1727'

1938	REPORT
6/1	Location
6/10	20" @ 60'.
	SD 100'.
6/17	15" - 119' Drlg. 355'
6/24	12" @ 375'.. Anhy 727'.
	Drlg. 1045'.
7/1	10" - 731' Drlg. 2160'
7/8	8" - 2440'.. Drlg. 2755'.
7/15	Lans. 2897'.. 6" - 2900'.
	1/2 BWPH & S. O. 2995-3000'.
	S. O. 3038-40'.. Dlg. 3130'.
7/22	Arb. 3143'. Oil 3149-53'.
	2000' oil in 8 hrs. 7" - 3143'.
	Drilled to 3154'. 2500' oil 7
	hrs. Swab 20 oil per hour.
	500' off bottom. S.W.
7/29	T. D. 3154'. Testing.
	OVER

1938

8/3 7" at 3143'.

Arb. 3143'.

T. D. 3153'.

Potential 901 bbls. Nat'l.

No water.

COMPLETED

Russell

KANSAS

Map No. 72 Sec. 31 Twp. 14 R. 14WWell No. 1 SolbachAylward Prod. Company

Contractor

FIRST REPORT

SE NE

____ Ft. from N. Line

330 Ft. from S. Line330 Ft. from E. Line

____ Ft. from W. Line

SECTION PLAT

Location X

Rig up _____

Drilling and Remarks:

RECORD

Cased _____ in., _____ ft.

Sand _____

Gas _____

Oil _____

Total Depth _____

PRODUCTION

1st 24 hrs. Nat. _____

1st 24 hrs. after shot _____

Gas _____ Cu. Ft.

Dry Hole _____

Abandoned _____

Date

JUN 1 - 1938 19 H. D. Hatfield Scout

RAY

Returned	
Cards	<i>Paul</i>
Tracing	<i>CRK</i>
France Map	<i>X</i>
Scarborough Map	<i>RAY</i>
Moody Map	<i>X</i>
Scarborough Plat Book	
Moody Plat Book	

Handwritten scribbles and lines at the top of the page, including a large 'Z' shape and a signature that appears to be 'R. W. H.'.

Returned	_____
Cards	Paul _____
Tracing	Joe _____
France Map	_____
Scarborough Map	_____
Moody Map	_____
Scarborough Plat Book	_____
Moody Plat Book	_____