

Section 31 Township 14 Range 14W

Well No. #2 Solbach "North"

Company Aylward Production


NORTH

						0	

SOUTH

WEST

EAST

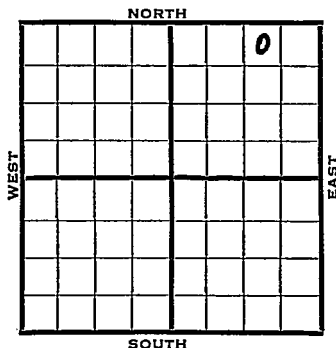

COMPLETED

Map No. 72 Sec. 31 Twp. 14 R. 14WWell No. 2 Solbach

Aylward Production

Company

Contractor

FIRST REPORT

SECTION PLAT

NW NE NE

			o

330 Ft. from N. Line

Ft. from S. Line

990 Ft. from E. Line

Ft. from W. Line

BIG CREEK POOL

Location X

Rig up

Drilling and Remarks:

RECORD

Cased _____ in., _____ ft.

Sand _____

Gas _____

Oil _____

Total Depth _____

PRODUCTION

1st 24 hrs. Nat. _____

1st 24 hrs. after shot _____

Gas _____ Cu. Ft.

Dry Hole _____

Abandoned _____

Date

JUL 10 1940 19

S. J. LEWIS Scout

Map No. 72 Sec. 31 Twp. 14 R. 14WWell No. 2 Solbach "North"Aylward Prod.

Company

CORRECTION

Contractor

NW NE NE

330 Ft. from N. Line Ft. from S. Line990 Ft. from E. Line Ft. from W. Line

BIG CREEK POOL

SECTION PLAT

			o

Location Rig up

Drilling and Remarks:

Reported as

#2 Solbach

RECORD

Cased in., ft.Sand Gas Oil Total Depth

PRODUCTION

1st 24 hrs. Nat. 1st 24 hrs. after shot Gas Cu. Ft.Dry Hole Abandoned

Date

JUL 31 1940 19

S. J. LEWIS

Scout

Russell

Map No. _____ Sec. 31 Twp. 14 R. 14W

Well No. 2 Solbach "North"

Aylward Production Company

Contractor _____

COMPLETED

NW NE NE

330 Ft. from N. Line

_____ Ft. from S. Line

990 Ft. from E. Line

_____ Ft. from W. Line

BIG CREEK POOL

SECTION PLAT

			o

Location _____

Rig up _____

Drilling and Remarks:

Lans 2953

6" @ 2953

7000 acid

Pump 3065 2X

May 3000

RECORD

Cased _____ in., _____ ft.

Sand _____

Gas _____

Oil _____

Total Depth 3054

PRODUCTION

1st 24 hrs. Nat. _____

1st 24 hrs. after shot _____

Gas _____ Cu. Ft.

Dry Hole _____

Abandoned _____

Date

AUG 28 1940 19

S. J. LEWIS Scout