


Section 31 Township 14 Range 11W

Well No. 5 Solback

Company A. E. Seeley

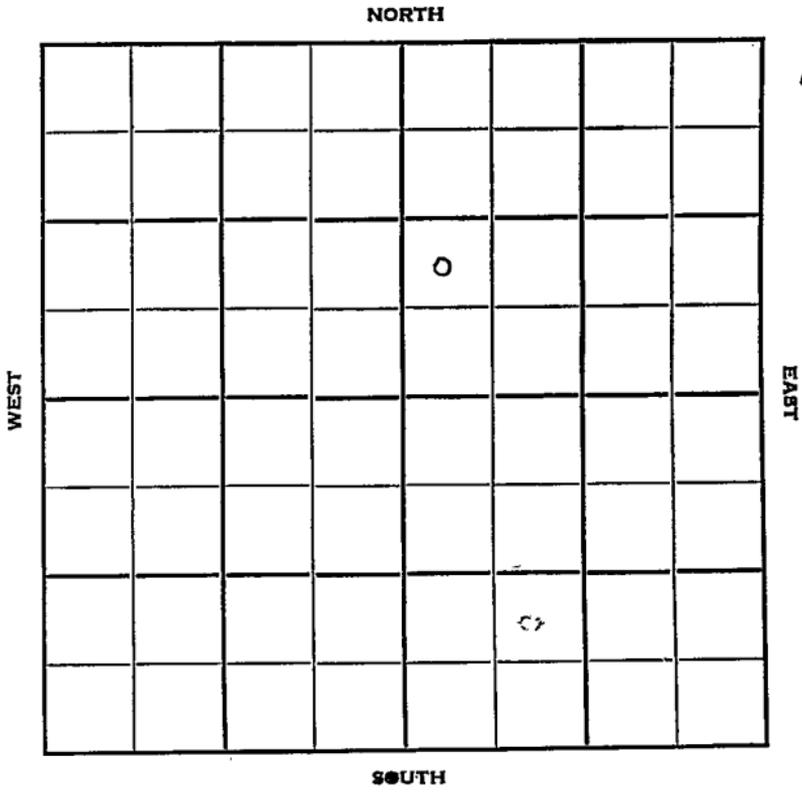

Russell

KANSAS

Sec. 31 Twp. 11 R. 11 W ✓

Well No. # 5 Solback Farm

A. E. Seeley Company

Contractor

Gorham Pool


Ft. from N. Line

990 Ft. from S. Line

Ft. from E. Line

330 Ft. from W. Line

NW SW NE

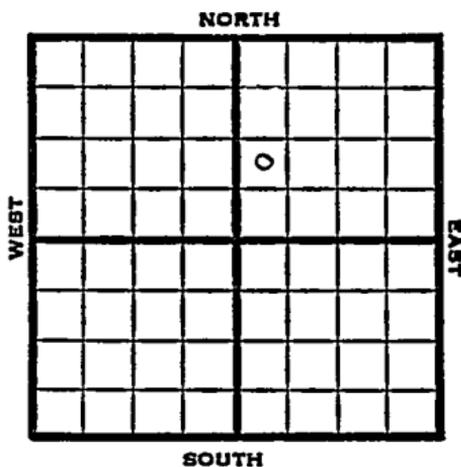

1951

Elev. 1733' REPORT

7/25

Spud 7-22-51
8" @ 743'
Drlg. 900'

8/29

Spud 7-22-51
Oil Well TD 3190
8" @ 743
Anhy 745
Top. 2630
Heeb. 2856
Lans. 2914
Arb. 3152-90
5" @ 3190
10/3152-55 FU 2500' oil 8 hr.
Comp. 50 bopd

COMPLETED

County **Russell** State **Kansas**

Sec. **31** (Blk. Twp.) **14** (Sur. Rge.) **14W** Map No.

Operator **A. E. Seeley**

Well No. **5** Farm **Solback**

Elev. Location **NW SW NE**

FIRST REPORT											

990 Ft. From **S** Line **NE**
 330 Ft. From **W** Line **Quarter**
JUL 25 1951

1st. Report

Completion

Remarks

Spudding Date **7-22-51**

Drlg. Data **Gorham Pool**

8" @ 743 drlg. 900

J. E. TYRA

