

KANSAS

FORM 51 25M 3-49 PETROLEUM

Trego

Section 32 Township 14 Range 24W

Well No. 1 E. Jesse


Company Stanolind

Wildcat

NORTH

WEST

EAST

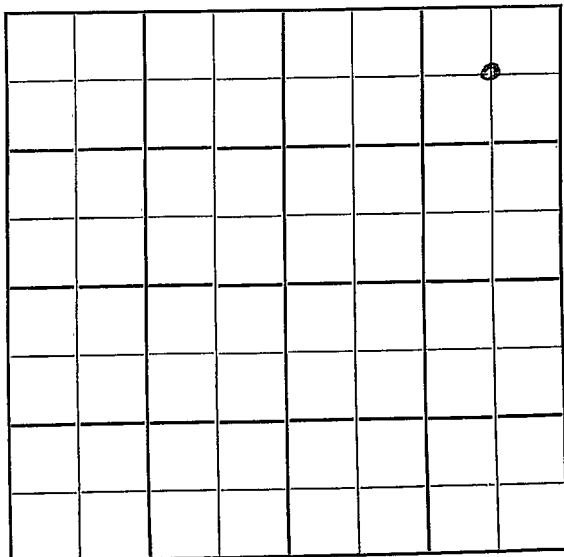

SOUTH

KANSAS

Trego ✓

Sec. 32 Twp. 14 R. 24W

Well No. 1 E. Jesse Farm

Stanolind Company

Wildcat


660 Ft. from N. Line

 Ft. from S. Line

660 Ft. from E. Line

 Ft. from W. Line

C NE NE

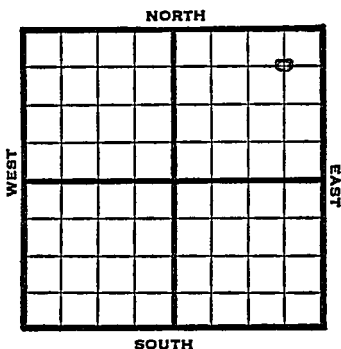

1949

Elev. 2247' REPORT

9/28

Loc.

10/5

13" @ 238'

Drlg 1658'

10/12

Drlg 3253'

10/19

Lansing 3403'

Mississippi 4022'

Viola 4266'

Drlg 4270'

10/26

Arb 4349'

TD 4515'

ABANDONED

Map No. _____ Sec. 32 Twp. 14 R. 24W

Well No. 1 E. Jesse

Stanolind

Company

Contractor

C NE NE


FIRST REPORT
SECTION PLAT

660 Ft. from N. Line

Ft. from S. Line

660 Ft. from E. Line

Ft. from W. Line

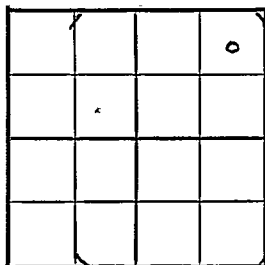

Trego County

RECORD

Location X

Rig up _____

Drilling and Remarks:

Cased _____ in., _____ ft.

Sand _____

Gas _____

Oil _____

Total Depth _____

PRODUCTION

1st 24 hrs. Nat. _____

1st 24 hrs. after shot _____

Gas _____ Cu. Ft.

Dry Hole _____

Abandoned _____

Date

SEP 28 1949

S. J. LEWIS Scout

Kansas

Wildcat

Map No. _____ Sec. 32 Twp. 14 R. 24WWell No. 1 E. Jesse

Stanolind

Company

ABANDONED

Contractor

C NE NE

E 1.2247
SECTION PLAT660 Ft. from N. Line Ft. from S. Line660 Ft. from E. Line Ft. from W. Line

			0

Trego County

Location _____

Rig up _____

Drilling and Remarks:

CR 4349

RECORD

Cased _____ in., _____ ft.

Sand _____

Gas _____

Oil _____

Total Depth 4515

PRODUCTION

1st 24 hrs. Nat. _____

1st 24 hrs. after shot _____

Gas _____ Cu. Ft.

Dry Hole _____

Abandoned _____

Date

OCT 26 1949

19

S. J. LEWIS

Scout