


O. W. D. D.

Section 32 Township 14 Range 14 W

Well No. # 1 Solbach

Company Woodley & Robinson

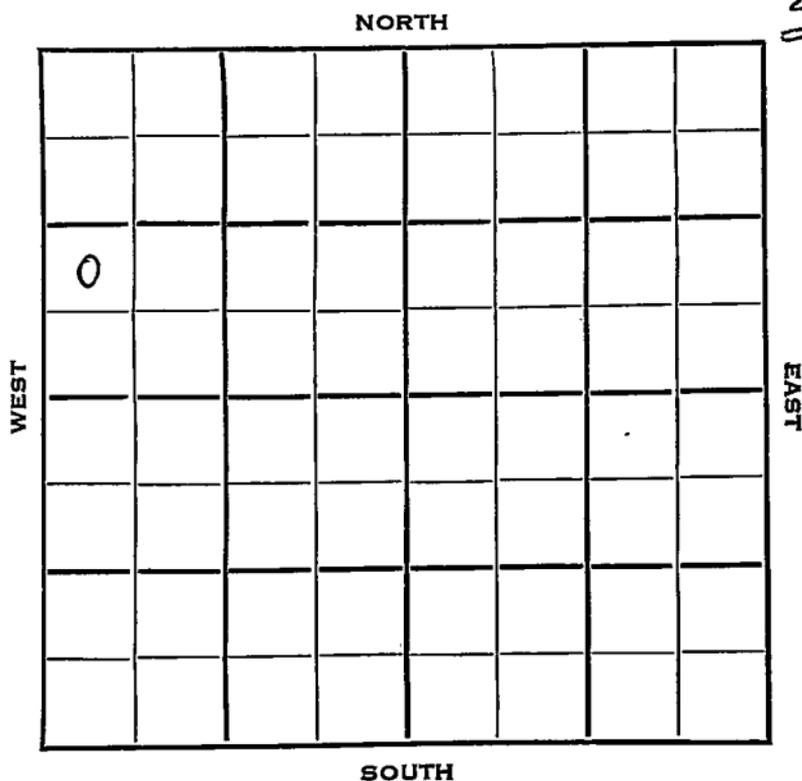

O W D D Russell

KANSAS

SEC.	TWP.	R.
32	14	14 W ✓

WELL NO. # 1 Solbach FARM

COMPANY Woodley & Robinson

CONTRACTOR Shields

Trapp Pool


_____ Ft. from N. Line

990 _____ Ft. from S. Line

_____ Ft. from E. Line

330 _____ Ft. from W. Line

NW SW NW

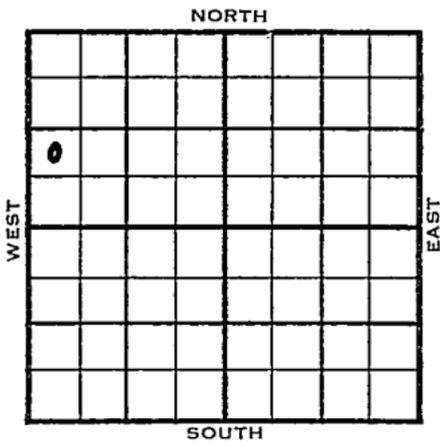

	ELEVATION	REPORT
1953	1726'	-

12/2

Location

12/9

Drlg. 30'

12/16

15" @ 25'
13" @ 360'
Drlg. 435'

1954

2/3

Spud 12-7-53 D & A TD 3163
15" @ 25 13" @ 360 A_{nh} 727
10" @ 731 Tarkio 2325 8" @ 2351
KC 2905 7" @ 2909 Arb. 3148
5" @ 3150 DD 3151 '500 A dry
DD 3158 500 A Dry TD 3163
D & A

1954

3/17

ABANDONED
O. W. D. D
Oil well TD 3169 Arb. 3148
5" @ 3150 OTD 3163 DD 3169
1000 A Comp. 13 BOPD

FIRST REPORT

COMPLETED

County Russell State Kansas

Sec. 32 (Blk. Twp.) 14 (Sur. Rge.) 14W Map No.

Operator Woodley & Robinson

Well No. 1 Farm Solbach

Elev. _____ Location NW SW NW

0					
FIRST REPORT					

990 Ft. From S Line NW

330 Ft. From W Line Quarter

1st. Report DEC 2 1953

Completion _____

Remarks _____

Shields - Contr.

Spudding Date _____

Drlg. Data Trapp Pool

Location

J. G. McGEHEE

