
FORM 51

Ellis KANSAS

Section 34 Township 14 Range 16 W

Well No. # 1 Dortland

Company Cities Service

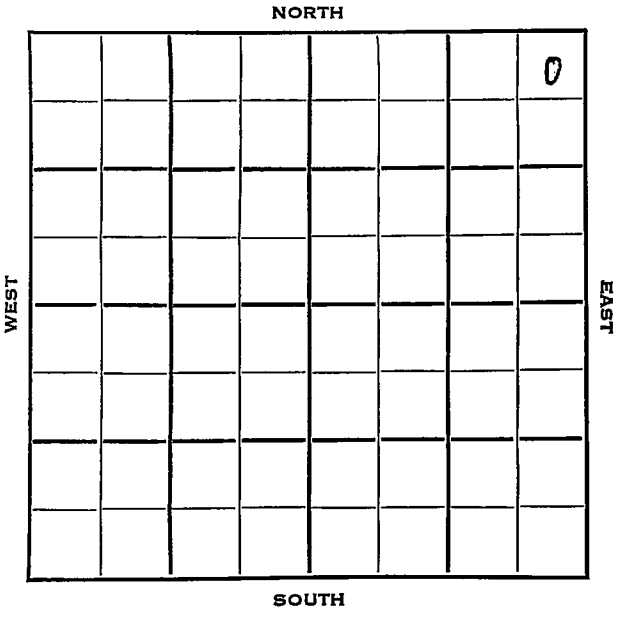

FORM 252-B

Ellis

KANSAS

Sec. 34 Twp. 14 R. 16W

Well No. #1 Dortland Farm

Cities Service Company

L & J. Drlg. Contractor

SE Dreiling Pool


330 Ft. from N. Line

Ft. from S. Line

330 Ft. from E. Line

Ft. from W. Line

NE NE NE

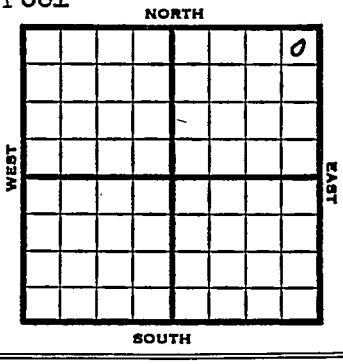

1953	REPORT
	Elev. 1831'
6/10	Spud 6-6-53 8" @ 687' Drlg 1197'
6/24	Spud 6-6-53 D & A TD 3372 8" @ 687 Heeb 3031 Dodge 3050 Lans 3067 DST 3078-3111 open 1 hr rec 80' mud & SW DST 3097-3111 open 1 hr rec 60' mud & SW DST 3142-57 open 1 hr rec 60' SO & GCM 1020# DST 3160-78 open 1 hr rec 35' mud 540# Cong 3330 Arb. 3347 DST 3348-55 open 1 hr rec 7' mud 0# DST 3354-62 open 1 hr rec 25' mud & SSO 100# TD 3372' D & A

ABANDONED

FORM 275 FOR SALE BY KANSAS BLUE PRINT CO.

County Ellis State Kansas

Sec. 34 (Blk. Twp.) 14 (Sur. Rge.) 16W Map No.

Operator Cities Service

Well No. 1 Farm Dortland

Elev. Location NE NE NE



330 Ft. From N Line NE

330 Ft. From E Line Quarter

1st. Report JUN 10 1953

Completion

Remarks

T. & J Drlg. - Contr.

Spudding Date 6-6-53

Drlg. Data SE Drilling Pool

8" @ 687 drlg. 1197

J. G. McGEHEE

FORM 275 FOR SALE BY KANSAS BLUE PRINT CO.


County Ellis State Kansas

Sec. 34 (Blk. Twp.) 14 (Sur. Rge.) 16W Map No.

Operator Cities Service

Well No. 1 Farm Dortland

Elev. 1831 Location NE NE NE

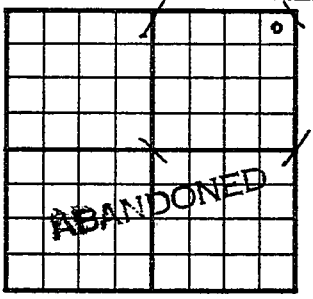

330 Ft. From N Line NE

330 Ft. From E Line Quarter

1st. Report

Completion JUN 24 1953

Remarks SE Dreiling Pool

L & J Drlg. - Contr.

Spudding Date 6-6-53

Drlg. Data D & A TD 3372

8" @ 687 Heeb. 3031 Dodge 3050 Lans. 3067 DST 3078-3111 open 1 hr. Rec. 80' mud & sw DST 3097-3111 open 1 hr. Rec. 60' mud & sw DST 3142-57 open 1 hr. Rec. 60' so & gcm 1020# DST 3160-78 open 1 hr. Rec. 35' mud 540# Cong. 3330 Arb. 3347 DST 3348-55 open 1 hr. Rec. 7' mud 0# DST 3354-62 open 1 hr. Rec. 25' mud & SSO 100# TD 3372

D & A

J. G. McGEHEE