

PETROL
KARCAS

Section 34 Township 14 Range 14W

Well No. 2 Mae

Company NCRA

Hall-Gurney
NORTH

NORTH

WEST

EAST

SOUTH

0

Sec. 34 Twp. 14 R. 14W


Well No. #2 Mai Farm

NCRA

Company

Hall-Gurney (NCRA, Cont.)

NORTH

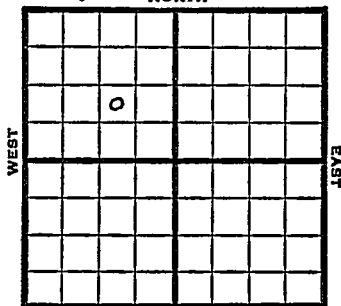

Ft. from N. Line

990'

Ft. from S. Line

990'

Ft. from E. Line

Ft. from W. Line

NW SE NW

SOUTH

1949

Elev. 1720' REPORT

8/10

Location

8/17

"

8/24

"

8/31

Rig

9/7

"

9/14

15" @ 45'
12" @ 382'
10" @ 700'
Drlg 1700'

9/21

8" @ 2150'
Drlg. 2260'

9/28

8" @ 2377'
Drlg 2450'

10/5

Lansing 2942'
Drlg 3018

10/12

Arb. 3188'
TD 3202
5" @ 3202'

10/19

"

10/26

"

11/2

TD 3210'
Lansing 2942'
Arb. 3188'
5 @ 3202'
Perf Lans
6000 acid
Pump 34 Oil / 43 W Pot
40⁹ Gr.
Comp

COMPLETED

Map No. _____ Sec. 34 Twp. 14 R. 14W

Well No. 2 Mai

NCRA

Company

NCRA

Contractor

**FIRST REPORT
SECTION PLAT**

NW SE NW

	o		

_____ Ft. from N. Line

990 _____ Ft. from S. Line

990 _____ Ft. from E. Line

_____ Ft. from W. Line

Russell County

Location X

Rig up

Drilling and Remarks:

RECORD

Cased _____ in., _____ ft.

Sand _____

Gas _____

Oil _____

Total Depth _____

PRODUCTION

1st 24 hrs. Nat. _____

1st 24 hrs. after shot _____

Gas _____ Cu. Ft.

Dry Hole _____

Abandoned _____

Date

AUG 10 1949

19

S. J. LEWIS

Scout

Scout Cards	
Land Small Map	
Land Wall Map	
Tracings	
France Map	
Pierce Map	
Misc.	

Kansas

Map No. _____ Sec. 34 Twp. 14 R. 14WWell No. 2 Mai


N C R A

Company

COMPLETE

Contractor

NW SE NW

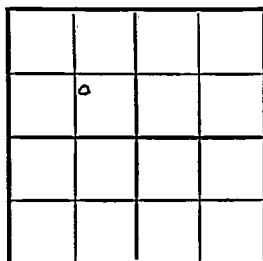E11720
SECTION PLAT

_____ Ft. from N. Line

990 Ft. from S. Line990 Ft. from E. Line

_____ Ft. from W. Line

Russell County

RECORD

Location _____

Cased _____ in., _____ ft.

Rig up _____

Sand _____

Drilling and Remarks:

Gas _____

Oil _____

Total Depth 8210

PRODUCTION

1st 24 hrs. Nat. _____

1st 24 hrs. after shot _____

Gas _____ Cu. Ft.

Dry Hole _____

Abandoned _____

Date

40 3/4

NOV 2 1949 19

S. J. LEWIS

Scout

*Loma 2942**Cr 48188**5 C 3202**Ref. Loma**6000 acid**Pump 34 oil + 43 W**40 3/4*

Scout Cards

Land Small Map

Land Wall Map

Tracings

France Map

Pierce Map

Misc.

South

8-7-1949