

Section 35 Township 14 Range 16WWell No. #1 JanzCompany M. B. Armer

NORTH							
				0			
SOUTH							
WEST							EAST

3-19-50
need a Completion
ticket
Lamm

Ellis

KANSAS

Sec. 35 Twp. 14 R. 16W

Well No. #1 Janz Farm

M. B. Armer

Company

Wildcat (Armer, Contr.)

NORTH

330'


Ft. from N. Line

Ft. from S. Line

Ft. from E. Line

330'

Ft. from W. Line

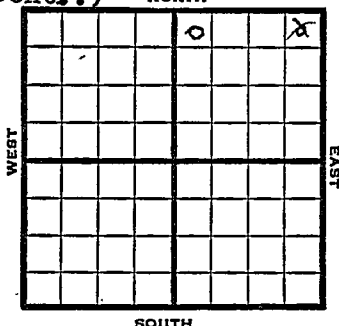

NW NE

1949

Elev 1829

R E P O R T

11/23

8" @ 600'

11/29

Drlg 2906'

12/7

Lansing 3077'

Arb. 3331-35'

TD 3335'

5" @ 3332'

12/14

TD 3272' HFW

Plug 3190'

10 shots 3148-53 - 500 acid

Swb 4 b ls oil P H, 8 hrs.

12/21

"

12/28

"

5/17

TD 3272

8" @ 600

Lans 3077

Abb 3331

5" @ 3332

P5 BO / 150 BWPD

D&A

ABANDONED

Map No. _____ Sec. 35 Twp. 14 R. 16W

Well No. 1 Janz

M. B. Armer Company

Armer Contractor

NW NE

FIRST REPORT
SECTION PLAT

330 Ft. from N. Line

_____ Ft. from S. Line

_____ Ft. from E. Line

330 Ft. from W. Line

		D	
		4	

Ellis County

Location _____

Rig up _____

Drilling and Remarks:

8" @ 600

RECORD

Cased _____ in., _____ ft.

Sand _____

Gas _____

Oil _____

Total Depth _____

PRODUCTION

1st 24 hrs. Nat. _____

1st 24 hrs. after shot _____

Gas _____ Cu. Ft.

Dry Hole _____

Abandoned _____

Date

NOV 23 1949

19

S. J. LEWIS

Scout

Map No. _____ Sec. Kansas 35 Twp. 14 R. 16W

Well No. 1 Kunz

M. B. Armer Company

Contractor

N^W NE


El. 1829
SECTION PLAT

330 Ft. from N. Line

_____ Ft. from S. Line

_____ Ft. from E. Line

330 Ft. from W. Line

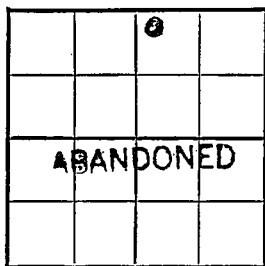

Elips

Location _____

Rig up _____

Drilling and Remarks:

8" @ 600

Land 3077

and 3331

5" @ 3332

P5 B0 + 150 BW PD

D+A

RECORD

Cased _____ in., _____ ft.

Sand _____

Gas _____

Oil _____

Total Depth 3272

PRODUCTION

1st 24 hrs. Nat. _____

1st 24 hrs. after shot _____

Gas _____ Cu. Ft.

Dry Hole _____

Abandoned ☒

Date

MAY 17 1950

J. E. TYRA Scout