
FORM 51

Ellis KANSAS

Section 35 Township 14 Range 16 W

Well No. # 2 Kunz

Company M. B. Armer

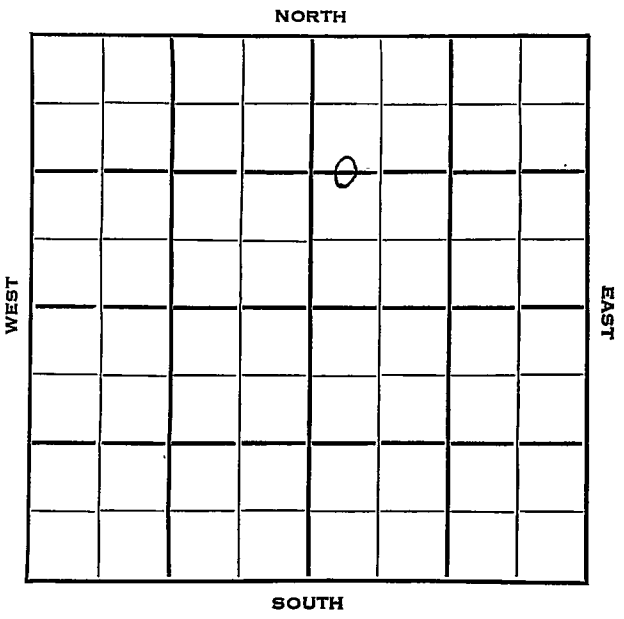

Ellis KANSAS

SEC.	TWP.	R.
35	14	16W

WELL NO.

2 Kunz FARM

COMPANY

M. B. Armer

CONTRACTOR

Armer


SE Dreiling Pool

1320 Ft. from N. Line

Ft. from S. Line

Ft. from E. Line

330 Ft. from W. Line

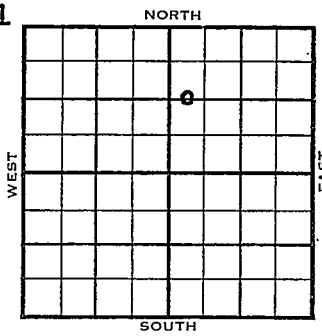

C W/2 W/2 NE

	ELEVATION	
1954	1859'	REPORT
5/12	MIR	
5/19	Anhy 965' 8" @ 971 Drlg. 2500'	
5/26	Spud 5-12-54 D&A TD 3410' Anhy 965' 8" @ 971' Heeb 3066', Lans 3119', Cong 3361', Arb. 3391' TD 3410' D&A	

ABANDONED

DX-78

FORM 275 FOR SALE BY KANSAS BLUE PRINT CO.


County Ellis State Kansas

Sec. 35 (Blk. Twp.) 14 (Sur. Rge.) 16W Map No.

Operator M. R. Armer

Well No. 2 Farm Kunz

Elev. Location C W½ W½ NE

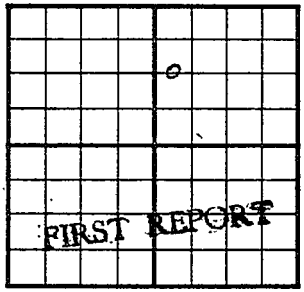

1320 Ft. From N Line NE

330 Ft. From W Line Quarter

1st. Report MAY 12 1954

Completion

Remarks

Armer - Contr.

Spudding Date

Drlg. Data SE Dreiling Pool

M I R

J. G. McGEHEE

FORM 275 FOR SALE BY KANSAS BLUE PRINT CO.


County Ellis State Kansas

Sec. 35 (Blk. Twp.) 14 (Sur. Rge.) 16W Map No.

Operator M. B. Armer

Well No. 2 Farm Kunz

Elev. 1859 Location C W½ W½ NE

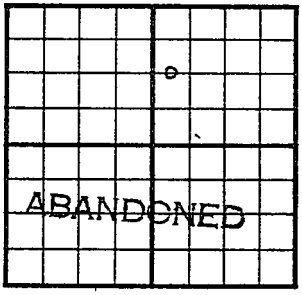

1320 Ft. From N Line NE

330 Ft. From W Line Quarter

1st. Report

Completion MAY 26 1954

Remarks SE Dreiling Pool

Armer - Contr.

Spudding Date 5-12-54

Drlg. Data D & A TD 3410

Anhy 965 8" @ 971 Heeb. 3066

Lans. 3119 Cong. 3361 Arb. 3391

TD 3410

D & A

J. G. McGEHEE