


DX 78-1 Ellis

KANSAS

Section 35 Township 14 Range 16W

Well No. #1 Wellbrock

Company L. D. Stableford

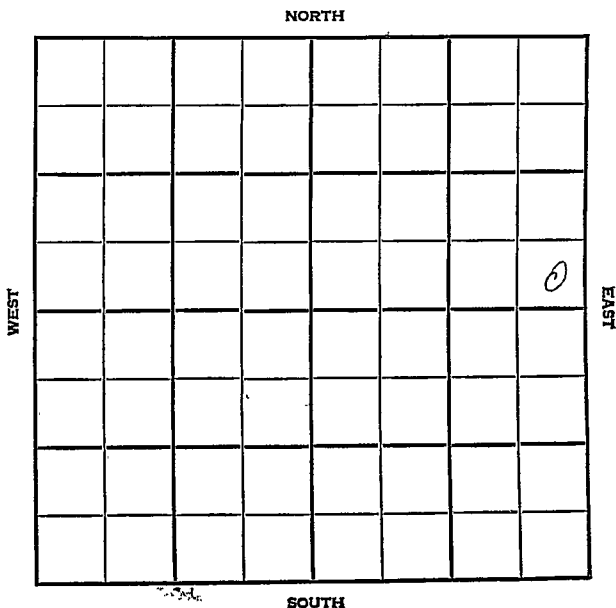

Ellis

KANSAS

SEC. 35 - - - TWP. 14 R. 16W

WELL NO.

#1 Wellbrook

FARM

COMPANY

L.B. Stableford

CONTRACTOR

Peel

SE Dreiling


\_\_\_\_\_ FT. FROM N. LINE

\_\_\_\_\_ FT. FROM S. LINE

\_\_\_\_\_ FT. FROM E. LINE

\_\_\_\_\_ FT. FROM W. LINE

SE SE NE

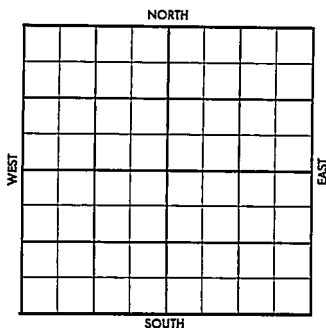

1956

ELEVATION

1878 KB

1875DF

REPORT

5-29

Comm. 5-22-56

8" @ 261

Drlg. 3173

H. 3079', L. 3133'

6-13

3187- 3221 60 min. Sli. bla.

rec. 175' 0 &amp; GCM,

BHP 770

DST 3256-3298 45 min. rec. 30' M

BHP 0#

RTD 3500'

5" @3499 w/150 co pf 24/3216-20

N.S. 2000 A.

\$ 2 boph

20/3221-26

20/3208-18

16/2198-3202 2000A.

\$ 90% w

no. rec. load

D &amp; A

Tr. 30', Cgl. 3370', A. 3475'

**ABANDONED**

County Ellis Elev. 1878 KB  
 Sec. 35 Twp. 14 Rge. 16W  
 Company L. B. Stableford  
 Farm Name Wellbrock No. 1

TOPS	DEPTH	LOG	DATUM
Anh.			
TP.			
H.	3079		
Tr.			
Dg.			
BL.			
L.	3133		
K.C.			
B.K.C.			
Ce.			
C.			
M.			
M.			
K.			
Mz.			
Me.			
V.			
S.			
S.			
A.			
R.			
PE.			
G.			
T.D.			

Loc. in Sec. SE SE NE  
 Geol. \_\_\_\_\_  
 Contr. \_\_\_\_\_  
 Pool Pool  
 Pool \_\_\_\_\_  
SE Drilling

**FIRST REPORT**  
 MAY 29 56

Date Comm. 5-22-56  
8 1/2 @ 261 drlg. 3173

*[Large handwritten scribble/signature across the bottom section]*

Co.  
 Loc.  
 No.  
 Sec.  
 T.  
 R.

FORM 513. SUNRAY

31475  
12

Co.

Lse.

No.

Sec.

T.

R.

County Elk Elev. 1878 KB  
 Sec. 35 Twp. 14 Rge. 16W 1875D7  
 Company L. B. Stableford  
 FarmName Wellbrock No. 1

TOPS	DEPTH	LOG	DATUM
Anh.			
TP			
H.	3079		
Tr.	30		
Dg.			
Bl.			
L.	3133		
K.C.			
B.K.C.			
Ce.	3370		
C.			
M.			
M.			
K.			
Mz.			
Ma.			
V.			
S.			
S.			
A.	3475		
R.			
PE.			
G.			
TD.	3500		

Loc. in Sec. SE SE NE  
 Geol. \_\_\_\_\_  
 Contr. \_\_\_\_\_  
 Pool \_\_\_\_\_  
SE Drilling

JUN 13 '56  
 ABANDONED

Date Comm. 5-22-56  
8" @ 21 drlg. 3173 JUN 6 '56

3187 - 3221 (60) Sli bla  
rec 175' O+GCM OHP 770  
DST 3256 - 3298 (45) rec 30' M  
BHP 0  
RTP 3500 5" 3499/150  
LO PF 24/3216-20 N.S.  
2000 A 2 BHP JUN 13 '56  
20/3221-26 29/3208-18

FORM 513-1 SUNRAY

35-14-10 W

SESENE

16/3198 -3202

2000 A

\$ 9074

No rec load

DEA